


STATE OF KANSAS
STATE CORPORATION COMMISSION

Give All Information Completely
Make Required Affidavit
Mail or Deliver Report to:
- Conservation Division
State Corporation Commission
212 North Market, Insurance Bldg.
Wichita, Kansas

15. 009. 00268. 00.00
WELL PLUGGING RECORD

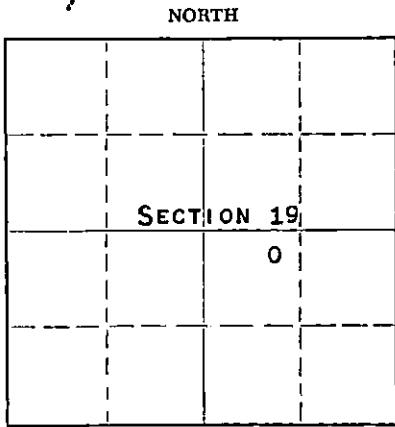

Locate well correctly on above
Section Plat

BARTON County. Sec. 19 Twp. 18S Rge. 11W (#) (W)
Location as "NE/CNW&SW" or footage from lines NW NW SE
Lease Owner PETROLEUM, INC.
Lease Name FEIST Well No. 1
Office Address ROUTE 2, GREAT BEND, KANSAS
Character of Well (completed as Oil, Gas or Dry Hole) DRY HOLE
Date well completed OCTOBER 5 19 59
Application for plugging filed OCTOBER 5 19 59
Application for plugging approved OCTOBER 5 19 59
Plugging commenced OCTOBER 5 19 59
Plugging completed OCTOBER 5 19 59
Reason for abandonment of well or producing formation NO PRODUCIBLE ZONES

If a producing well is abandoned, date of last production ONE 19 59
Was permission obtained from the Conservation Division or its agents before plugging was commenced? YES

Name of Conservation Agent who supervised plugging of this well DONALD TRUAN, 634 SUNSET, RUSSELL, KANSAS
Producing formation Depth to top Bottom Total Depth of Well 3480' Feet
Show depth and thickness of all water, oil and gas formations.

OIL, GAS OR WATER RECORDS

CASING RECORD

FORMATION	CONTENT	FROM	TO	SIZE	PUT IN	PULLED OUT
				8-5/8"	266'	NONE

Describe in detail the manner in which the well was plugged, indicating where the mud fluid was placed and the method or methods used in introducing it into the hole. If cement or other plugs were used, state the character of same and depth placed, from feet to feet for each plug set.

MUD UP WITH HEAVY MUD TO 240' FOLLOWED BY A WOODEN PLUG AND 1/4 SACK OF HULLS, PLACED 20 SACKS OF CEMENT THROUGH DRILL PIPE ON TOP OF PLUG. MUD UP TO 35' FOLLOWED BY A WOODEN PLUG AND 1/4 SACK OF HULLS. FILLED HOLE TO BASE OF WELL CELLAR WITH 10 SACKS OF CEMENT.

RECEIVED
STATE CORPORATION COMMISSION
OCT 23 1959
CONSERVATION DIVISION

(If additional description is necessary, use BACK of this sheet)
Name of Plugging Contractor GARVEY DRILLING COMPANY
Address ROUTE 2, GREAT BEND, KANSAS

STATE OF KANSAS, COUNTY OF BARTON, ss.
DON SEARIE (employee of owner) or ~~XXXXXXXXXX~~ of the above-described well, being first duly sworn on oath, says: That I have knowledge of the facts, statements, and matters herein contained and the log of the above-described well as filed and that the same are true and correct. So help me God.

(Signature) Don Searie
ROUTE 2, GREAT BEND, KANSAS
(Address)

SUBSCRIBED AND SWORN TO before me this 19TH day of OCTOBER, 19 59

My commission expires APRIL 14, 1963
Arthur J. Wiles
ARTHUR J. WILES Notary Public.



15.009.00268.00.00
WELL LOG

COMPANY PETROLEUM, INCORPORATED

SEC. 19 T. 18S R. 11W

FARM FEIST

NO. 1


LOC. NW, NW, SE

TOTAL DEPTH 3480'

COUNTY BARTON CO., KANSAS

COMM. September 27, 1959 COMP. October 5, 1959

CONTRACTOR GARVEY DRILLING COMPANY

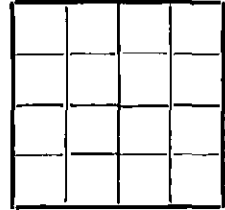

CASING 8 5/8" @ 266' W/175 sax.

ELEVATION

PRODUCTION D & A

FIGURES INDICATE BOTTOM OF FORMATIONS

266	Surface clay & red bed
675	Red bed
692	Anhydrite
1320	Shale & shells
1705	Shale, salt & lime
1900	Shale & lime
2105	Shale
2520	Shale & shells
2643	Shale
2715	Lime & shale
2830	Shale & lime
2920	Lime
3110	Lime & shale
3315	Lime
3438	Lime & shale
3480	Lime
3480	T. D.

State of KANSAS
County of BARTON } ss:

I, VERNE A. MORRIS of GARVEY DRILLING COMPANY

upon oath state that the above and foregoing is a true and correct copy of the log of the #1 FEIST well.

Verne A. Morris

Subscribed and sworn to before me this 16th day of October 19 59

My Commission Expires: April 14, 1963

Arthur J. White
NOTARY PUBLIC