


WELL PLUGGING RECORD

Give All Information Completely
Make Required Affidavit
Mail or Deliver Report to:
Conservation Division
State Corporation Commission
800 Bitting Building
Wichita, Kansas

NORTH

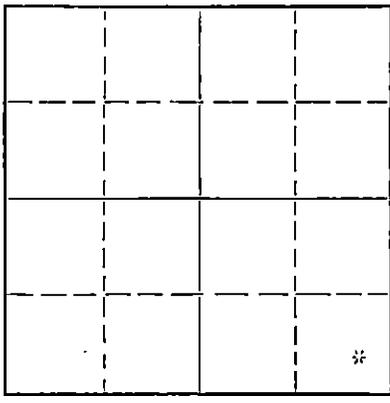

Locate well correctly on above
Section Plat

Barton County, Sec. 31 Twp. 19 Rge. 13 (E) (W)
Location as "NE/CNW/SW" or footage from lines S⁷/SE/33⁷/₄
Lease Owner Poindexter Brothers
Lease Name J. Schridde Well No. 1
Office Address 2600 Bonita, Great Bend, Kansas
Character of Well (completed as Oil, Gas or Dry Hole) Dry Hole
Date well completed February 28 19 55
Application for plugging filed February 28 19 55
Application for plugging approved February 28 19 55
Plugging commenced February 28 19 55
Plugging completed February 28 19 55
Reason for abandonment of well or producing formation Dry Hole

If a producing well is abandoned, date of last production 19
Was permission obtained from the Conservation Division or its agents before plugging was commenced? Yes

Name of Conservation Agent who supervised plugging of this well Warren Horner
Producing formation Depth to top Bottom Total Depth of Well 3735 Feet
Show depth and thickness of all water, oil and gas formations.

OIL, GAS OR WATER RECORDS

CASING RECORD

Formation	Content	From	To	Size	Put In	Pulled Out
Surface		0	765	8 5/8	765	None

Describe in detail the manner in which the well was plugged, indicating where the mud fluid was placed and the method or methods used in introducing it into the hole. If cement or other plugs were used, state the character of same and depth placed, from feet to feet for each plug set.

Filled with heavy mud to top
Put in cement plug.
Pumped 100 sacks cement through swedge
down pipe.
Globe Oilwell Cementing, Inc. pumped plug

(If additional description is necessary, use BACK of this sheet)

Name of Plugging Contractor Globe Oilwell Cementing, Inc.
Address Box 628, Great Bend, Kansas

STATE OF Kansas COUNTY OF Barton, ss.
A.L. Jackson, Drlr. Contractor on (employee of owner) or (owner or operator) of the above-described well,
being first duly sworn on oath, says: That I have knowledge of the facts, statements, and matters herein contained and the log of the above-described well as filed and that the same are true and correct. So help me God.

(Signature) A. L. Jackson
Box 194, Great Bend, Kansas (Address)

SUBSCRIBED AND SWORN TO before me this 1st day of March, 19 55

My commission expires May 9, 1955 Notary Public.

23-8390-s 6-51-20M

PLUGGING
FILED SEC 31 T 19 R 13W
BOOK PAGE 101 LINE 3

RECEIVED
MAR 7 1955
CONSERVATION DIVISION
Wichita, Kansas

Boindexter Brothers

Well Log
J. Schridde # 1
Barton County, Kansas

SESESE
Sec 31-19-13 W

0 - 40	Surface Clay and Sand
40 - 100	Sand, Gravel and clay
100 - 125	Shale
125 - 300	Shale and Shells
300 - 350	Shale
350 - 500	Sand - Dakota
500 - 755	Red Bed and Shale
755 - 730	Anhydrite
780 - 1240	Red Bed, Shale, Shells
1240 - 1485	Salt
1485 - 1565	Shale and Shells
1565 - 1685	Lime Streaks, Shale and Shells
1685 - 1810	Lime, and Shale
1810 - 1870	Sandy Lime
1870 - 2025	Lime
2025 - 2165	Lime and Shale Streaks
2165 - 2260	Lime
2260 - 2350	Lime and Shale
2350 - 2630	Shale and Lime Streaks
2630 - 2700	Lime and Shale
2700 - 2770	Shale and Lime
2770 - 2925	Lime and Shale
2925 - 2960	Lime and Shale Streaks
2960 - 3005	Lime
3005 - 3065	Lime - Topeka
3065 - 3075	Lime
3075 - 3080	Heebneer
3080 - 3176	Lime and Shale
3176 - 3212	Lime
3212 - 3224	Lime-Kansas City
3224 - 3455	Lime
3455 - 3462	Conglomerate
3462 - 3550	Arbuckle
3550 - 3610	Lime
3610 - 3735	Arbuckle
3735	T.D.

STATE OF KANSAS
COUNTY OF BARTON ss

A. L. Jackson, owner of A.L. Jackson Drilling Company, being first duly sworn on oath, says: That I have knowledge of the facts, statements, and matters herein contained and the log of the above described well as filed and that the same are true and correct.

A. L. Jackson
A. L. Jackson
Box 194
Great Bend, Kansas

Subscribed and sworn to before me this 4 day of March, 1955.

My Commission Expires May 9, 1955

Alvin D. Cross

PLUGGING
FILE sec 31/19-13W
BOX PAGE 12/LINE 3