


STATE OF KANSAS
 STATE CORPORATION COMMISSION
 Give All Information Completely
 Make Required Affidavit
 Mail or Deliver Report to:
 Conservation Division
 State Corporation Commission
 800 Bitting Building
 Wichita, Kansas

15-009-05940-0900
WELL PLUGGING RECORD

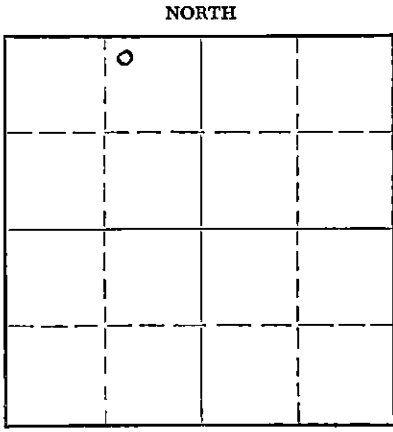

Locate well correctly on above Section Plat

Barton County. Sec. 15 Twp. 16 Rge. 12 (E) (W)
 Location as "NE/CNW/SW" or footage from lines. NW-NE-NW
 Lease Owner Derby Oil Co.
 Lease Name Kramer Well No. 5
 Office Address Wichita, Kansas
 Character of Well (completed as Oil, Gas or Dry Hole) Dry Hole
 Date well completed 7-21 1954
 Application for plugging filed " 19"
 Application for plugging approved " 19"
 Plugging commenced " 19"
 Plugging completed " 19"
 Reason for abandonment of well or producing formation Dry Hole

If a producing well is abandoned, date of last production _____ 19____
 Was permission obtained from the Conservation Division or its agents before plugging was commenced? Yes

Name of Conservation Agent who supervised plugging of this well State Pluggers - Homer, Great Bend, Kans.
 Producing formation _____ Depth to top _____ Bottom _____ Total Depth of Well 3352 Feet
 Show depth and thickness of all water, oil and gas formations.

OIL, GAS OR WATER RECORDS

CASING RECORD

FORMATION	CONTENT	FROM	TO	SIZE	PUT IN	PULLED OUT
		0'	548'	8 5/8"	548	none

Describe in detail the manner in which the well was plugged, indicating where the mud fluid was placed and the method or methods used in introducing it into the hole. If cement or other plugs were used, state the character of same and depth placed, from _____ feet to _____ feet for each plug set.

From	3352'	to	260'	Heavy Rotary Mud.
"	260'	"	258 1/2'	Wooden Plug.
"	258 1/2'	"	197'	20 sax. Cem. 1/3 sax hulls.
"	197'	"	38'	Heavy Rotary Mud.
"	38'	"	36 1/2'	Wooden Plug
"	36 1/2'	"	6'	10 sax cem. 1/3 sax hulls.
"	6'	"		Surface to cellar.

(If additional description is necessary, use BACK of this sheet)

Name of Plugging Contractor Peel Brothers, Inc.
 Address Box 88 - Hoisington, Kansas

STATE OF Kansas COUNTY OF Barton, ss.
Peel Brothers, Inc. (employee of owner) or (owner or operator) of the above-described well, being first duly sworn on oath, says: That I have knowledge of the facts, statements, and matters herein contained and the log of the above-described well as filed and that the same are true and correct. So help me God. PEEL BROTHERS, INC.
 (Signature) BY [Signature]
Box 88 - Hoisington, Kansas
 (Address)

SUBSCRIBED AND SWORN to before me this 23 day of July, 19 54
Norma L. Rose
 Notary Public.

My commission expires September 28, 1957

24-7366-S 3-53-20M
PLUGGING
 FILE SEC 15 T 16 R 12W
 BOOK PAGE 30 LINE 30

07-28-54

DRILLER'S LOG

Company: Derby Oil Company

NW-NE-NW

Sec: 15, Twn: 16, Rge: 12

Farm: Kramer Well No: 5

Total Depth: 3352'

County: Barton, Kansas

Comm: 7/8/54 Comp: 7-21-54
Contractor: Peel Brothers, Inc.

Elevation:

Casing: 8 5/8" @ 548' Cem.

Production: Dry

Figures below indicate bottom of formation

Clay and Post Rock	0'	35'
Shale		250
Shale and sand streaks		340
Shale and shells		450
Shale		575
Red bed		795
Anhydrite		825
Red bed and shale		950
Shale and shells		1085
Shale		1265
Shale and salt streaks		1465
Shale and lime streaks		1610
Lime and shale streaks		1730
Brown lime and shale		1830
Lime and shale streaks		1985
Shale and lime streaks		2115
Lime and shale		2340
Shale and lime streaks		2665
Shale and lime		2790
Lime		3324
Conglomerate		3347
Dolomite		3352
Total Depth		3352

This is to certify that the above information is to the best of my knowledge true and correct.

PEEL BROTHERS, INC.

BY *R. E. Sutton*

SUBSCRIBED AND SWORN TO before me this 23 day of July 1954

My commission expires September 28, 1957

Thomas L. Reese
Notary Public

PLUGGING
SEC 15 T 16 R 12W
DATE PAID 50 June 30