


15-009-06720-0000
WELL PLUGGING RECORD

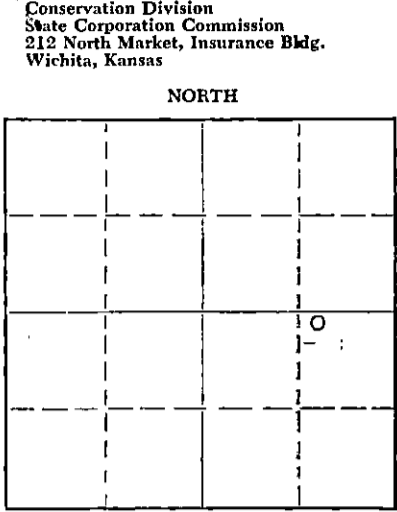

Locate well correctly on above Section Plat

Barton County. Sec. 15 Twp. 15 Rge. 16 (E) 22 (W)
 Location as "NE/CNW/SW" or footage from lines NW NE SE
 Lease Owner Nadel and Gussman
 Lease Name Hoffman Well No. 1
 Office Address 1714 First Natl Bldg. Tulsa 3, Oklahoma
 Character of Well (completed as Oil, Gas or Dry Hole) _____
 Date well completed _____ 5-21-1959
 Application for plugging filed _____ 5-21-1959
 Application for plugging approved _____ 5-21-1959
 Plugging commenced _____ 5-21-1959
 Plugging completed _____ 5-21-1959
 Reason for abandonment of well or producing formation Dry

If a producing well is abandoned, date of last production _____ 19____
 Was permission obtained from the Conservation Division or its agents before plugging was commenced? Yes

Name of Conservation Agent who supervised plugging of this well _____ 3430
 Producing formation _____ Depth to top _____ Bottom _____ Total Depth of Well 3370 Feet
 Show depth and thickness of all water, oil and gas formations.

| OIL, GAS OR WATER RECORDS | | | | | CASING RECORD | |
|---------------------------|---------|------|----|-------|---------------|------------|
| FORMATION | CONTENT | FROM | TO | SIZE | PUT IN | PULLED OUT |
| | | | | 8-5/8 | 273 | 0 |
| | | | | | | |
| | | | | | | |
| | | | | | | |
| | | | | | | |
| | | | | | | |
| | | | | | | |
| | | | | | | |

Describe in detail the manner in which the well was plugged, indicating where the mud fluid was placed and the method or methods used in introducing it into the hole. If cement or other plugs were used, state the character of same and depth placed, from _____ feet to _____ feet for each plug set.

Filled hole with heavy mud from T.D. to 250' - set plug with 25 sacks of cement.
Top plug set at 40' with 10 sacks cement to surface

RECEIVED
 STATE CORPORATION COMMISSION
 SEP 10 1959
 CONSERVATION DIVISION
 Wichita, Kansas

(If additional description is necessary, use BACK of this sheet)
 Name of Plugging Contractor Reserve Drilling Company, Inc.
 Address 625 Union Center, Wichita 2, Kansas

STATE OF KANSAS COUNTY OF SEDGWICK, ss.
L. C. Hay (employee of owner) of the above-described well, being first duly sworn on oath, says: That I have knowledge of the facts, statements, and matters herein contained and the log of the above-described well as filed and that the same are true and correct. So help me God.

(Signature) L. C. Hay
Wichita, Kansas
 (Address)

SUBSCRIBED AND SWORN TO before me this 25th day of May, 1959

My commission expires Nov. 3, 1960 _____ Notary Public.

PLUGGING
 File Sec. 15 T. 16 R. 12W
 Book Page 1 Line 13

Nadel and Gussman

Hoffman No. 1

NW NE SE 15-16-12W
Barton County, Kansas

Comm: 5-13-59
Comp: 5-21-59

Casing: 8-5/8" 273' w/175 sax

Formations

Depths

| | |
|-------------------|------|
| Limestone | 100 |
| Shale and lime | 273 |
| Shale | 385 |
| Sandy lime | 520 |
| Shale and shells | 610 |
| Shale and red bed | 824 |
| Anhydrite | 845 |
| Shale | 1040 |
| Shale and shells | 1595 |
| Lime and shale | 2793 |
| Lime | 3370 |
| Lime and shale | 3430 |

Geological Tops

| | |
|--------------|------|
| Topoka | 2742 |
| Heebner | 3024 |
| Toronto | 3043 |
| Brown Lime | 3116 |
| Lansing | 3132 |
| Conglomerate | 3399 |
| Arbuckle | 3420 |

RECEIVED
STATE CONSERVATION COMMISSION
SEP 10 1959
CONSERVATION DIVISION
Wichita, Kansas

STATE OF KANSAS)
) SS:
COUNTY OF SEDGWICK)

L. C. Hay, of lawful age, states that the above formations and depths are correct to his best knowledge.

L. C. Hay

L. C. Hay

Subscribed and sworn to before me this 25th day of May, 1959.

Nola Babb

Nola Babb, Notary Public

My commission expires Nov. 3, 1960

PLUGGING

File Sec. 15 T 16 R 12W
Book Page 1 Line 13