


Give All Information Completely
Make Required Affidavit
Mail or Deliver Report to:
Conservation Division
State Corporation Commission
211 No. Broadway
Wichita, Kansas

15-009-07-260-0000
WELL PLUGGING RECORD

Barton County, Sec. 15 Twp. 16 Rge. 12 (E) W (W)

Location as "NE/CNW&SW" or footage from lines SW NW SW
Lease Owner Morgenstern & Specter, Inc.
Lease Name Ehly Well No. 4
Office Address Russell, Kansas
Character of Well (completed as Oil, Gas or Dry Hole) _____
Date well completed _____ 19____
Application for plugging filed _____ 19____
Application for plugging approved _____ 19____
Plugging commenced 6-15-64 _____ 19____
Plugging completed 6-24-64 _____ 19____
Reason for abandonment of well or producing formation Depleted.

NORTH

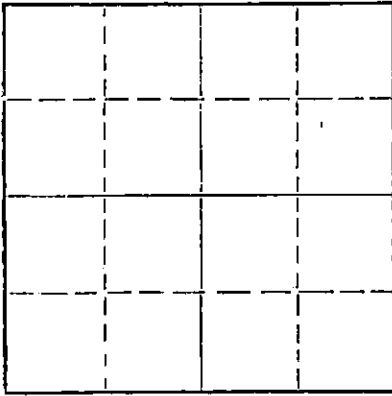

Locate well correctly on above
Section Plat

If a producing well is abandoned, date of last production _____ 19____
Was permission obtained from the Conservation Division or its agents before plugging was commenced? yes

Name of Conservation Agent who supervised plugging of this well Don Truan
Producing formation _____ Depth to top _____ Bottom _____ Total Depth of Well 3328 Feet
Show depth and thickness of all water, oil and gas formations.

OIL, GAS OR WATER RECORDS

CASING RECORD

| FORMATION | CONTENT | FROM | TO | SIZE | PUT IN | PULLED OUT |
|-----------|---------|------|----|--------|--------|------------|
| | | | | 8-5/8" | 501' | None |
| | | | | 5-1/2" | 3321' | 2465' |
| | | | | | | |
| | | | | | | |
| | | | | | | |
| | | | | | | |

Describe in detail the manner in which the well was plugged, indicating where the mud fluid was placed and the method or methods used in introducing it into the hole. If cement or other plugs were used, state the character of same and depth placed, from _____ feet to _____ feet for each plug set.

Checked hole to 3328', sanded to 3310' and dumped 5 sacks of cement @ 3310' with dump bailer. Pulled 5 1/2" casing, bailed fluid from 200' to 300', set rock bridge to 190' and dumped 25 sacks of cement @ 190' with dump bailer. Mudded hole to 40', set rock bridge to 30'; and ran 10 sacks of cement to base of cellar.

RECEIVED
STATE CORPORATION COMMISSION

JUL 2 1964 07-02-64

PLUGGING COMPLETE.

CONSERVATION DIVISION
Wichita, Kansas

(If additional description is necessary, use BACK of this sheet)

Name of Plugging Contractor KNIGHT CASING PULLING COMPANY
Address CHASE, KANSAS

STATE OF KANSAS, COUNTY OF RICE, ss.
Noel J. Knight (employee of owner) or (~~owner~~) of the above-described well, being first duly sworn on oath, says: That I have knowledge of the facts, statements, and matters herein contained and the log of the above-described well as filed and that the same are true and correct. So help me God.

(Signature) Noel J. Knight
Chase, Kansas
(Address)

SUBSCRIBED AND SWORN TO before me this 25th day of June, 19 64

My commission expires May 20, 1968 Milton J. Volin Notary Public.


WELL LOG BUREAU KANSAS GEOLOGICAL SOCIETY
412 Union National Bk. Bldg., Wichita, Kansas

Company THE VICKERS PETROLEUM CO., INC.
Farm - Ohly No. 4

SEC. 15 T. 16 R. 12W
SW NW SW

Total Depth. 3326'
Comm. 9-13-47 Comp. 10-2-47
Shot or Treated:
Contractor.
Issued. 12-13-47

County. Barton
KANSAS

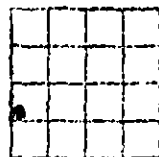

CASING:
8-5/8" 501' Csm. N/265 Sx.
5-1/2" 3321' Csm. W/80 Sx.

Elevation. _____
Production. Pot. Est.
100 BOPD

Figures indicate Bottom of Formations.

| | |
|--------------------|-----------|
| surface shale | 40 |
| sand & shale | 270 |
| sand Dakota | 370 |
| sand, sh. & shells | 450 |
| shale & shells | 510 |
| red b-d & red rock | 660 |
| red shale | 785 |
| anhydrite | 811 |
| shale & shells | 1240 |
| shale & salt | 1410 |
| shale & lime | 1715 |
| lime broken | 1850 |
| lime & shale | 2035 |
| lime broken | 2170 |
| shale & lime | 2500 |
| shale, lime broken | 2580 |
| lime | 2990 |
| shale & lime | 3110 |
| lime | 3320 |
| sand & shale | 3324 |
| dobomite | 3326 RTD |
| S.L.M. | 3326=3323 |
| Cable Tool Measure | 3323=3322 |
| sand | 3322=3328 |
| Pay | 3322=3328 |

Total Depth
TOPS:
Brown Lansing 3052 D.F.
White Lansing 3069 D.F.
Arbuckle 3319 D.F. Corr.
Reagan Sand 3321 D.F. Corr.

RECEIVED
STATE CORPORATION COMMISSION

JUN 17 1964

CONSERVATION DIVISION
Wichita, Kansas