


STATE OF KANSAS
STATE CORPORATION COMMISSION

15-009 - 22183 - 0000

WELL PLUGGING RECORD

Give All Information Completely
Make Required Affidavit
Mail or Deliver Report to
Conservation Division
State Corporation Comm.
245 North Water
Wichita, KS 67202

Barton County, Sec. 15 Twp. 26S Rge. 12 E/W
Location as "NE/CNW $\frac{1}{4}$ SW $\frac{1}{4}$ " or footage from lines _____
130' NE of SE NW SW
Lease Owner Petroleum Energy, Inc.
Lease Name Hofmeister Well No. 1
Office Address 710 One Twenty Bldg. Wichita, KS 67202
Character of Well (Completed as Oil, Gas or Dry Hole) _____
Dry Hole
Date Well completed 12-12 1980
Application for plugging filed 12-12 1980
Application for plugging approved 12-12 1980
Plugging commenced 12-12 1980
Plugging completed 12-12 1980
Reason for abandonment of well or producing formation _____

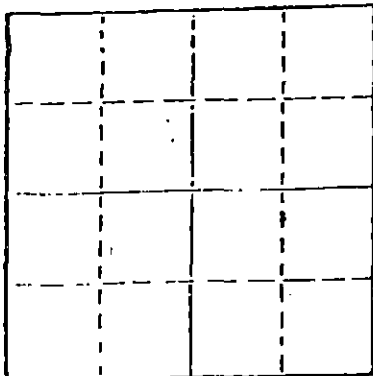

Locate well correctly on above
Section Plat

If a producing well is abandoned, date of last production _____
19

Was permission obtained from the Conservation Division or
its agents before plugging was commenced? yes

Name of Conservation Agent who supervised plugging of this well Duane L. Rankin
Producing formation _____ Depth to top _____ Bottom _____ Total Depth of Well 3349'
Show depth and thickness of all water, oil and gas formations.

OIL, GAS OR WATER RECORDS

CASING RECORD

FORMATION	CONTENT	FROM	TO	SIZE	PUT IN	PULLED OUT
				8 5/8"	304'	none

Describe in detail the manner in which the well was plugged, indicating where the mud fluid
was placed and the method or methods used in introducing it into the hold. If cement or other
plugs were used, state the character of same and depth placed, from _____ feet to
_____ feet for each plug set.

- 50 sx cement @ 500'
- 30 sx cement @ 200'
- 10 sx cement @ 40'
- 5 sx in rathole.

(If additional description is necessary, use BACK of this sheet)

Name of Plugging Contractor White & Ellis Drilling, Inc.
401 E. Douglas, Suite 500, Wichita, KS 67202

STATE OF KANSAS COUNTY OF SEDGWICK, ss.
Ernest Sifford (employee of owner) or (owner or operator)
of the above-described well, being first duly sworn on oath, says: That I have knowledge of
the facts, statements, and matters herein contained and the log of the above-described well
as filed and that the same are true and correct. So help me God.

(Signature) [Signature]
401 E. Douglas - Suite 500, Wichita, Ks.
(Address) 67202

SUBSCRIBED AND SWORN TO before me this 29th day of December, 19 80.

CAROLYN J. TJADEN
NOTARY PUBLIC
STATE OF KANSAS
My Appt. Expires Sept. 5, 1984

[Signature]
Carolyn J. Tjaden
Notary Public.

My commission expires _____

STATE CORPORATION COMMISSION

DEC 30 1980

CONSERVATION DIVISION
Wichita, Kansas

DRILLERS LOG

OPERATOR: Petroleum Energy, Inc., 710 One Twenty Bldg., Wichita, KS 67202
 CONTRACTOR: White & Ellis Drilling, Inc., Box 448, El Dorado, Kansas 67042

Lease Name Hofmeister Well No. 1
 Sec. 15 T. 26S R. 12W Spot 130' NE of SE NW SW
 County Barton State Kansas Elevation _____

Casing Record:

Surface: 8 5/8" @ 304' with 200 ^{3% cc} 2% gel Sxs.

Production: _____ @ _____ with _____ Sxs.

Type Well: D & A Total Depth 3349'

Drilling Commenced: 12-3-80 Drilling Completed 12-12-80

Formation	From	To	Tops
Cellar	0	7	
Shale, Lime	7	2598	
Lime	2598	3349	

RECEIVED
 STATE CORPORATION COMMISSION

DEC 30 1980

CONSERVATION DIVISION
 Wichita, Kansas

COMPLETION RECORD

Liner Record: Size _____ From _____ To _____
 Cementing Record: _____ Sacks _____
 Perforating Record: _____

Formation	Perforated Interval	Number Shots

Initial Production: _____

Electric Log _____ Type and Depths Covered _____

