


STATE OF KANSAS  
STATE CORPORATION COMMISSION

Form CP-4

Give All Information Completely  
Make Required Affidavit  
Mail or Deliver Report to:  
Conservation Division  
State Corporation Commission  
211 No. Broadway  
Wichita, Kansas

WELL PLUGGING RECORD

NORTH

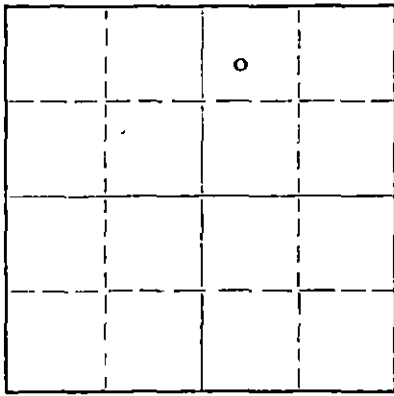

Locate well correctly on above  
Section Plat

Rice County, Sec. 34 Twp. 21S Rge. 9W (E) (W)  
Location as "NE/CNW/SW" or footage from lines c NW NE  
Lease Owner Kern Drilling Co., Inc., & Hellar Drilling Co., Inc.  
Lease Name Hilda Smith Well No. 1  
Office Address 1014 Union Center, Wichita, Kansas 67202  
Character of Well (completed as Oil, Gas or Dry Hole) Dry Hole  
Date well completed August 10 19 65  
Application for plugging filed August 10 19 65  
Application for plugging approved August 10 19 65  
Plugging commenced August 10 19 65  
Plugging completed August 10 19 65  
Reason for abandonment of well or producing formation Dry Hole

If a producing well is abandoned, date of last production 19  
Was permission obtained from the Conservation Division or its agents before plugging was commenced? Yes

Name of Conservation Agent who supervised plugging of this well Gilbert Toman, P. O. Box 180, Holyrood, Kansas  
Producing formation Depth to top Bottom Total Depth of Well 3720' Feet  
Show depth and thickness of all water, oil and gas formations.

OIL, GAS OR WATER RECORDS

CASING RECORD

FORMATION	CONTENT	FROM	TO	SIZE	PUT IN	PULLED OUT
		0	245'	8 5/8"	245'	None

Describe in detail the manner in which the well was plugged, indicating where the mud fluid was placed and the method or methods used in introducing it into the hole. If cement or other plugs were used, state the character of same and depth placed, from feet to feet for each plug set.

Set Plug @ 235'/20 sacks cement/1/2 sack hulls  
20'/10 sacks cement/1/2 sack hulls

RECEIVED  
STATE CORPORATION COMMISSION

AUG 10 1965

CONSERVATION DIVISION  
Wichita, Kansas

8-16-65

(If additional description is necessary, use BACK of this sheet)

Name of Plugging Contractor Hellar Drilling Company, Inc.  
Address 1014 Union Center, Wichita, Kansas

STATE OF Kansas, COUNTY OF Sedgwick, ss.  
D. L. Hellar, Pres. of Hellar Drig. Co. Inc. (employee of owner) or (owner or operator) of the above-described well, being first duly sworn on oath, says: That I have knowledge of the facts, statements, and matters herein contained and the log of the above-described well as filed and that the same are true and correct. So help me God.

(Signature) D. L. Hellar, President  
1014 Union Center, Wichita, Kansas 67202  
(Address)

SUBSCRIBED AND SWORN TO before me this 13th day of August, 1965

My commission expires March 25, 1968  
Catherine Darcey  
Catherine Darcey Notary Public.

DRILLER'S LOG

COMPANY: Kern Drilling Co., Inc., & Hellar Drilling Co., Inc.  
 CONTRACTOR: Hellar Drilling Company, Inc., Wichita, Kansas  
 LEASE: #1 Hilda Smith  
 LOCATION: c NW NE 34-21S-9W, Rice County, Kansas  
 COMMENCED: July 31, 1965  
 COMPLETED: August 10, 1965  
 CASING: Set 8 5/8" surface casing @ 245'/225 sacks cement

0-70	Sand
70-785	Red Bed
785-1325	Salt Section
1325-1423	Lime & Shale
1423-1590	Ft. Riley Cherty lime
1590-1994	Lime & Shale
1994-2292	Shale & Lime
2292-3043	Lime & Shale
3043-3180	Lime (L.-K.C.)
3180-3359	K. C. Lime & Sh. streaks
3359-3450	Lime & Shale w/chert
3450-3472	Lime
3472-3498	Core #1 (Lime & sand)
3498-3550	Lime & chert
3550-3586	Viola Section
3586-3700	Lime & chert
3700-3720	Arbuckle dolomite
3720	Rotary Total Depth
	D & A

**RECEIVED**  
 STATE CORPORATION COMMISSION

AUG 10 1965

CONSERVATION DIVISION  
 Wichita, Kansas

STATE OF KANSAS     )  
                               ) SS  
 COUNTY OF SEDGWICK )

I, D. L. Hellar, do hereby certify that the above and foregoing is a true and correct copy of the log of the #1 Hilda Smith, located c NW NE 34-21S-9W, Rice County, Kansas, as reflected by the files of the Hellar Drilling Company, Inc.

HELLAR DRILLING COMPANY, INC.

By *D. L. Hellar*  
 President - D. L. Hellar

Subscribed and sworn to before me, a Notary Public, in and for Sedgwick County, Kansas, this 13th day of August, 1965.

*Catherine Darcey*  
 Notary Public - Catherine Darcey

My Commission Expires:  
 March 25, 1968.