

STATE OF KANSAS  
STATE CORPORATION COMMISSION

Give All Information Completely  
Make Required Affidavit  
Mail or Deliver Report to:  
Conservation Division  
State Corporation Commission,  
800 Bitting Building,  
Wichita, Kansas

WELL PLUGGING RECORD  
OR  
FORMATION PLUGGING RECORD

Strike out upper line  
when reporting plug-  
ging off formations.

*pd.*  
*11/8/37*  
*Ha*

*11-8-37*

Rice County. Sec. 8 Twp. 21S Rge. (E) 9 (W)

Location as "NE $\frac{1}{4}$ NW $\frac{1}{4}$ SW $\frac{1}{4}$ " or footage from lines NE Corner SE $\frac{1}{2}$

Lease Owner Elbar Corporation

Lease Name Olive Watson Ehlers Well No. 1

Office Address 33 South Clark Street, Chicago, Illinois

Character of Well (Completed as Oil, Gas or Dry Hole) Dry Hole

Date, well completed October 27 1937

Application for plugging filed October 27 1937

Application for plugging approved October 29 1937


Plugging Commenced October 29 1937

Plugging Completed October 31 1937

Reason for abandonment of well or producing formation

If a producing well is abandoned, date of last production 193

Was permission obtained from the Conservation Division or its agents before plugging was commenced? Yes

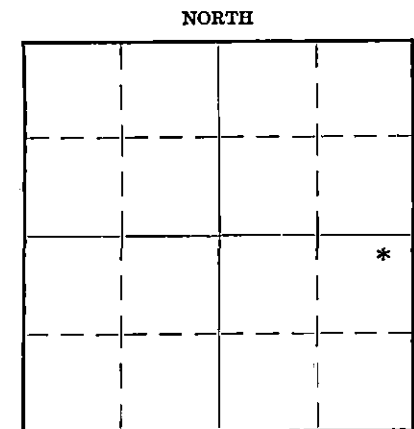

Locate well correctly on above  
Section Plat

Name of Conservation Agent who supervised plugging of this well Guy Wiershing, Lyons, Kansas

Producing formation Depth to top Bottom Total Depth of Well 3537 Feet

Show depth and thickness of all water, oil and gas formations.

OIL, GAS OR WATER RECORDS

CASING RECORD

Formation	Content	From	To	Size	Put In	Pulled Out
				12 $\frac{1}{2}$	85 ft.	none

Describe in detail the manner in which the well was plugged, indicating where the mud fluid was placed and the method or methods used in introducing it into the hole. If cement or other plugs were used, state the character of same and depth placed, from feet to feet for each plug set.

Hole was filled with 10 $\frac{1}{2}$  lb. mud and aquagel and wood plug driven to 250 ft.  
Surface was filled with 10 $\frac{1}{2}$  lb. mud with 25 sacks cement put on top, another plug put on top of cement and surface pipe welded over.

*pd.*  
*11/8/37*  
*Ha*

FILE NO. 8-21-R-94  
BOOK 114 NE 4-2

(If additional description is necessary use BACK of this sheet)

Correspondence regarding this well should be addressed to The Rose Spring Drilling Company  
Address 809 Ellis Singleton Building, Wichita, Kansas

STATE OF Kansas, COUNTY OF Sedgwick, SS.

S. A. Springer (employee of owner) or (owner or operator) of the above-described well, being first duly sworn on oath, says: That I have knowledge of the facts, statements, and matters herein contained and the log of the above-described well as filed and that the same are true and correct. So help me God.

(Signature) *S. A. Springer*

(Address)

SUBSCRIBED AND SWORN to before me this 6th day of November, 1937.

My commission expires July 31, 1941

*J. W. Beldner*  
Notary Public.

NOV 8 1937

OLIVE WATSON EHLERS # 1

NE Cor. SE $\frac{1}{4}$  Sec. 8-21s-9w  
Rice County, Kansas

Drilled for: Elbar Corporation  
Drilled by: Rose Spring Drilling Company

CASING RECORD:

12" 83'

Drilling Commenced: October 6, 1937  
Drilling Completed: October 27, 1937

<u>FORMATION</u>	<u>DEPTH</u>	<u>FORMATION</u>	<u>DEPTH</u>
sand & shells	76	lime	3483
red bed	258	sand & shale	3496
gyp & red bed	275	lime & shale	3510
GYP	293	shale & shells	3623
shale & gyp shells	540	lime	3537
shale & gyp	800		TOTAL DEPTH
shale & lime	939		
shale & lime shells	1181		
lime	1322		
lime, gyp & shale	1375		
hard lime	1400		
broken lime	1435		
lime & shale	1555		
lime	1772		
lime & shale	2166		
shale & shells	2251		
lime & shale	2412		
(2310 slight odor of oil)			
lime	2467		
shale	2518		
cored lime & shale	2534		
lime & shale	2688		
lime, streak of shale	2695		
lime & shale	2718		
sandy shale & lime	2799		
hard lime	2831		
lime & shale	2995		
lime	3015		
cored lime & shale	3034		
shale	3035		
cored broken lime	3052		
cored 1 ft. broken lime	3053		
lime	3086		
lime, broken	3179		
lime	3274		
lime & shale	3298		
coring (recovered con- glomerate & lime)	3316		
coring	3531		
cored red rock	3534		
Viola Lime	3430		

FILE NO. 8-21s-9w  
BOOK PAGE 114 DE-47

STATE OF KANSAS )  
                              ) SS  
COUNTY OF SEDGWICK)

I, the undersigned, being duly sworn on oath, state that the above and within statement is a true and correct record and log of the well drilled on the location above described, to the best of my knowledge and belief.

*[Signature]*

Subscribed and sworn to before me this 5 day of Nov 1937

*[Signature]*

By Commission Expires --

Notary Public

July 31-1941