

STATE OF KANSAS  
STATE CORPORATION COMMISSION

WELL PLUGGING RECORD  
OR  
FORMATION PLUGGING RECORD

Strike out upper line when reporting plugging off formations.

Give All Information Completely  
Make Required Affidavit  
Mail or Deliver Report to:  
Conservation Division  
State Corporation Commission,  
800 Bittling Building,  
Wichita, Kansas

*Rec'd  
6-22-36*

Rice County. Sec. 6 Twp. 21 Rge. 9 (W)

Location as "NE $\frac{1}{4}$ NW $\frac{1}{4}$ SW $\frac{1}{4}$ " or footage from lines SE corner SE $\frac{1}{4}$

Lease Owner C. E. Skiles

Lease Name Stout Well No. 1

Office Address 206 Exchange National Bank Bldg.

Character of Well (Completed as Oil, Gas or Dry Hole) dry hole

Date, well completed June 17 19 36

Application for plugging filed June 22 193 6

Application for plugging approved June 22, 1936 193 6


Plugging Commenced June 18, 19 193 6

Plugging Completed June 22 193 6

Reason for abandonment of well or producing formation dry

If a producing well is abandoned, date of last production 193

Was permission obtained from the Conservation Division or its agents before plugging was commenced? yes

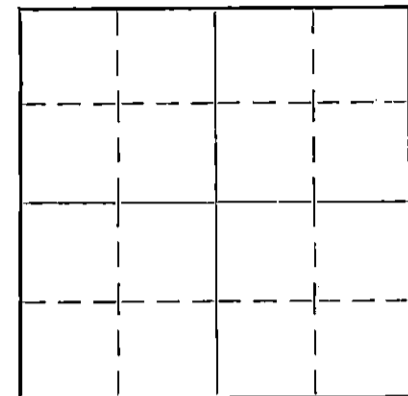

Locate well correctly on above Section Plat

Name of Conservation Agent who supervised plugging of this well Raymond Gear

Producing formation V Depth to top Bottom Total Depth of Well 3374 $\frac{1}{2}$  Feet

Show depth and thickness of all water, oil and gas formations.

OIL, GAS OR WATER RECORDS

CASING RECORD

| Formation  | Content           | From | To   | Size | Put In | Pulled Out |
|------------|-------------------|------|------|------|--------|------------|
| Water      | 1 $\frac{1}{2}$ B | 105  |      | 12 " | 71'    |            |
| Water      | 3 B               | 200  |      | 10 " | 780    |            |
| Water      |                   | 745  |      | 8 "  | 2180   |            |
| Water      | 4 B               | 1520 | 1530 | U.D. | 2428   |            |
| Little Gas |                   | 1880 |      | U.D. | 2496   |            |
| Little Gas |                   | 2410 |      | U.D. | 2518   |            |
| Gas        |                   | 2460 |      | U.D. | 2718   |            |
| Water      | HFV               | 2465 |      | U.D. | 2761   |            |

Describe in detail the manner in which the well was plugged, indicating where the mud fluid was placed and the method or methods used in introducing it into the hole. If cement or other plugs were used, state the character of same and depth placed, from feet to feet for each plug set.

|                |             |                    |      |          |       |  |
|----------------|-------------|--------------------|------|----------|-------|--|
| Water          | BWO         | 2500               | 2510 | 6 "      | 3197  |  |
| Water          | 1 B per hr. | 2580               | 2585 | 5" liner | 3371' |  |
| Water          | HFV         | 2638               |      |          |       |  |
| Water          | BW          | 2710               |      |          |       |  |
| Water          | HFV         | 2715               |      |          |       |  |
| Water          | BW          | 2770               |      |          |       |  |
| Little Oil     |             | 2976               | 2985 |          |       |  |
| Showing of Oil |             | 2992               |      |          |       |  |
| Water          | B           | 3055               | 3060 |          |       |  |
| Water          |             | 3152               | 3155 |          |       |  |
| Black Oil      |             | 3152               | 3155 |          |       |  |
| Water          | HFV         | 3374 $\frac{1}{2}$ |      |          |       |  |

PLUGGING  
FILE SET 6-21-36  
BOOK PAGE 50 LINE 17

Mud pumped into hole, cementing plug above each water formation.

(If additional description is necessary use BACK of this sheet)

Correspondence regarding this well should be addressed to C. E. Skiles  
Address 206 Exchange National Bank Building  
Hutchinson, Kansas

STATE OF Kansas COUNTY OF Reno, ss.

C. E. Skiles (employee of owner) or (owner or operator) of the above-described well, being first duly sworn on oath, says: That I have knowledge of the facts, statements, and matters herein contained and the log of the above-described well as filed and that the same are true and correct. So help me God.

(Signature) C. E. Skiles  
206 Exchange National Bank Bldg.  
Hutchinson, Kansas  
(Address)

SUBSCRIBED AND SWORN to before me this 23rd day of June, 19 36.

My commission expires April 1, 1940.

J. D. Starr  
Notary Public.

Well Log Record

15.159.05509.0000

SECS 6-21-9,  
Rice County, Kansas

Casing Record:


|          |       |        |       |
|----------|-------|--------|-------|
| 12"      | 71'   | 8"U.D. | 2428' |
| 10"      | 780'  | 8"U.D. | 2496' |
| 8"       | 2180' | 8"U.D. | 2518' |
| 6"       | 3197' | 8"U.D. | 2718' |
| Liner 5" | 3371' | 8"U.D. | 2761' |

Farm: J. B. Stout  
Company: Skiles, C. E. & Hinerman, O. F.  
Commenced: April 17, 1936  
Completed: June

Figured indicate bottom of formation

| Formation         | Depth | Formation           | Depth | Formation        | Depth    |
|-------------------|-------|---------------------|-------|------------------|----------|
| Sand              | 45    | Red Shale           | 1730  | Lime             | 2670     |
| Sand              | 63    | Lime Light          | 1735  | Sandy Lime       | 2675     |
| Red Rock          | 65    | Shale Red           | 1750  | Fighting Sand    | 2680     |
| Red Rock Sandy    | 90    | Lime Light          | 1760  | Lime Grey        | 2685     |
| Red Rock 1 1/2 BW | 105   | Lime Broken         | 1785  | Lime             | 2695     |
| Red Rock 3 BW     | 200   | Red Rock            | 1790  | Lime             | 2700     |
| Red Rock          | 280   | Lime Broken         | 1805  | Lime White       | 2705     |
| Red Rock          | 285   | Lime                | 1815  | Lime             | 2708     |
| Lime White        | 305   | Broken Lime         | 1835  | Lime             | 2708     |
| Blue Shale        | 365   | Blue Shale          | 1840  | BW               | 2710     |
| Blue Shale        | 435   | Lime Dark Broken    | 1850  | Lime Grey HFW    | 2715     |
| Blue Shale        | 510   | Lime Broken         | 1875  | Sand             | 2725     |
| Blue Shale        | 575   | Shale Dark          | 1880  | Lime             | 2733     |
| Blue Shale        | 645   | Lime Broken         | 1900  | Lime             | 2736     |
| Blue Shale        | 700   | Lime Broken         | 1920  | Water Sand       | 2745     |
| Blue Shale BW     | 745   | Lime Broken         | 1925  | Water Sand       | 2750     |
| Blue Shale        | 785   | Lime                | 1940  | Sandy Lime       | 2751     |
| Blue Shale        | 815   | Shale Blue          | 1950  | Sand             | 2759     |
| Blue Shale        | 816   | Lime                | 1960  | Lime             | 2765     |
| Salt              | 823   | Blue Shale          | 1980  | Lime Brown BW    | 2770     |
| Shale Dark        | 825   | Blue Shale          | 2000  | Lime             | 2800     |
| Salt              | 855   | Shale Blue-Shell    | 2045  | Shale            | 2802     |
| Salt              | 920   | Shale Blue          | 2095  | Lime Broken      | 2803     |
| Salt              | 965   | Shale               | 2130  | Lime Broken      | 2830     |
| Blue Shale        | 970   | Slate & Shells      | 2155  | Red Rock         | 2835     |
| Blue Shale        | 975   | Lime Hard           | 2160  | Shale            | 2880     |
| Salt              | 1030  | Slate & Shells      | 2175  | Shale Blue       | 2927     |
| Salt              | 1075  | Lime Gray           | 2180  | Shale Blue       | 2950     |
| Salt              | 1130  | Lime Soft           | 2195  | Lime             | 2952     |
| Slate & Shells    | 1140  | Broken Lime         | 2210  | Lime & Shale     | 2965     |
| Blue Shale        | 1154  | Blue Shale & Shells | 2235  | Lime             | 2990     |
| Lime White        | 1160  | Lime                | 2242  | Lime             | 2995     |
| Blue Shale        | 1165  | Blue Shale          | 2250  | Shale            | 3002     |
| Lime Brown Hard   | 1175  | Lime                | 2258  | Lime Grey        | 3007     |
| Shale Light       | 1190  | Blue Shale cave     | 2263  | Lime Brown       | 3010     |
| Slate & Shells    | 1223  | Lime                | 2265  | Lime Grey        | 3020     |
| Lime              | 1236  | Lime                | 2272  | Lime Broken BW   | 3040     |
| Shale & Shells    | 1240  | Blue Shale          | 2276  | Shelly           | 3060     |
| Slate & Shells    | 1280  | Lime                | 2287  | Lime Brown       | 3085     |
| Shale             | 1285  | Blue Shale          | 2290  | Lime             | 3115     |
| Shale Light       | 1290  | Blue Shale          | 2295  | Lime Grey        | 3148     |
| Shale Light       | 1350  | Lime                | 2308  | Lime Grey W      | 3155     |
| Lime              | 1355  | Brown Shale         | 2318  | Lime             | 3165     |
| Slate             | 1375  | Lime                | 2325  | Lime             | 3175     |
| Red Rock          | 1410  | Lime                | 2345  | Red Rock         | 3180     |
| Sandy Lime        | 1440  | Blue Shale          | 2355  | Lime Grey        | 3195     |
| Shale Light       | 1445  | Blue Shale          | 2395  | Lime Grey        | 3210     |
| Lime Broken       | 1465  | Lime                | 2415  | Lime             | 3223     |
| Lime White Hard   | 1475  | Lime                | 2425  | Lime             | 3238     |
| Lime Broken       | 1500  | Lime Grey           | 2440  | Red Rock         | 3244     |
| Broken Lime       | 1520  | Lime                | 2450  | Lime             | 3250     |
| Sandy 4 BW        | 1540  | Lime Broken HFW     | 2468  | Mud              | 3255     |
| Slate             | 1550  | Broken Lime         | 2486  | Lime Grey        | 3275     |
| Red Rock          | 1560  | Lime Broken         | 2494  | Conglomerate     | 3280     |
| Light Lime        | 1570  | Lime                | 2495  | Red Rock         | 3290     |
| Blue Shale        | 1595  | Sand Water BW       | 2510  | Conglomerate     | 3305     |
| Lime Light        | 1610  | Sandy Lime          | 2515  | Conglomerate     | 3313     |
| Blue Shale        | 1615  | Lime Grey           | 2527  | Shale Green      | 3320     |
| Blue Shale        | 1625  | Lime Grey           | 2535  | Lime             | 3327     |
| Lime Broken       | 1670  | Lime                | 2545  | Conglomerate     | 3334     |
| Lime              | 1675  | Lime                | 2560  | Lime             | 3340     |
| Red Rock          | 1680  | Lime Grey LBW hr.   | 2580  | Blue Shale       | 3355     |
| Lime              | 1685  | Lime                | 2595  | Blue Shale       | 3371     |
| Slate             | 1700  | Lime                | 2615  | Siliceous Lime   | 3372     |
| Red Rock          | 1705  | Lime Grey           | 2625  | Drilled in 2 ft. | 3374     |
| Lime              | 1715  | Lime                | 2635  | Siliceous Lime   | 3374 1/2 |
| Red Rock          | 1720  | Shale HFW           | 2640  | HFW              |          |
| Lime Light        | 1725  | Grey Sand           | 2650  |                  |          |
|                   |       | Lime                |       |                  |          |

LOGGING  
PAGE 52 LINE 14

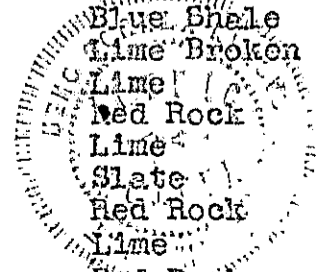

State of Kansas }  
County of Reno } SS

I hereby certify that the above is a true and exact copy of the driller's log.

C. E. Skiles

Subscribed and sworn to before me, a notary public, on this  
25<sup>th</sup> day of June, 1936.

G. O. Harr  
Notary Public

My commission expires April 1, 1940.