


WELL PLUGGING RECORD

Give All Information Completely
Make Required Affidavit
Mail or Deliver Report to:
Conservation Division
State Corporation Commission
212 No. Market
Wichita, Kansas

NORTH

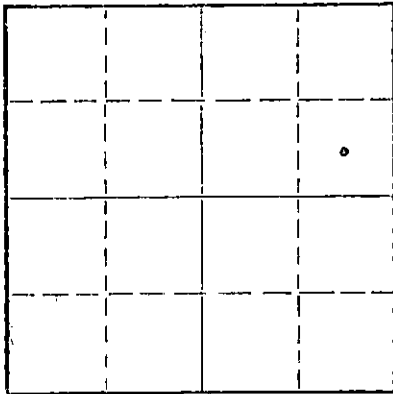

Locate well correctly on above
Section Plat

Rice County, Sec. 13 Twp. 21S Rge. (E) 8 (W)

Location as "NE/CNW/SW" or footage from lines SE NE
Lease Owner H. L. Herbel
Lease Name Smisor Farm Trust "A" Well No. 1
Office Address P.O. Box 327, Chase, Kansas
Character of Well (completed as Oil, Gas or Dry Hole) gas
Date well completed 19
Application for plugging filed November 21 19 68
Application for plugging approved 19
Plugging commenced November 27 19 68
Plugging completed November 30 19 68
Reason for abandonment of well or producing formation depleted

If a producing well is abandoned, date of last production 19
Was permission obtained from the Conservation Division or its agents before plugging was commenced? yes

Name of Conservation Agent who supervised plugging of this well Gilbert Toman
Producing formation Depth to top Bottom Total Depth of Well 3414 Feet
Show depth and thickness of all water, oil and gas formations.

OIL, GAS OR WATER RECORDS

CASING RECORD

FORMATION	CONTENT	FROM	TO	SIZE	PUT IN	PULLED OUT
		0	253'	8 5/8"	253'	none
		0	3413'	4 1/2"	3413'	2888.09

Describe in detail the manner in which the well was plugged, indicating where the mud fluid was placed and the method or methods used in introducing it into the hole. If cement or other plugs were used, state the character of same and depth placed, from feet to feet for each plug set.

Pushed plug to 3355', set 10' sand bridge and dumped 3 sacks of cement.

Pushed plug to 250', set 10' rock bridge and dumped 25 sacks of cement.
Filled hole with mud to 40' and capped hole with 10 sacks of cement.

RECEIVED
STATE CORPORATION COMMISSION
DEC 4 1968
CONSERVATION DIVISION
Wichita, Kansas

(If additional description is necessary, use BACK of this sheet)
Name of Plugging Contractor Pipe Pullers, Inc.
Address Box 486, Ellinwood, Kansas

STATE OF Kansas COUNTY OF Barton, ss.
Evelyn Roth (employee of owner) or (owner or operator) of the above-described well, being first duly sworn on oath, says: That I have knowledge of the facts, statements, and matters herein contained and the log of the above-described well as filed and that the same are true and correct. So help me God.

(Signature) Evelyn Roth
Ellinwood, Kansas (Address)

SUBSCRIBED AND SWORN TO before me this 3rd day of December 19 68

My commission expires Feb. 10, 1971

George A. Meyer Notary Public.

WELL LOG AND RELATED DATA
Mid-Continent Area

DIVISION Northern Producing DISTRICT Central (Buffalo-Kans.) LEASE Smisor Farm Trust "A"
ACRES 160 LEASE No. 54008 AFE No. 4517 ELEVATION Grd. 1626' D.F. 1628' WELL No. 1
TOWNSHIP 13 TWP. 21 S RGE. 8 W PRCT.-DIST.-TWP. (Bull Creek Miss. Pool)
SURVEY (Ball Prospect) COUNTY Rice STATE Kansas

LOG			
FROM	TO	TOTAL	FORMATION
0	3339	3339	Sand, shale, & lime
3339	BASAL PENN. CONG.		(E.L. Top)
3339	3357	18	Chert & shale
3357	MISS. CHAT		(E.L. Top)
3357	3393	36	Chert & shale
3393	KINDERHOOK		(E.L. Top)
3393	3414	21	Shale
3414			TOTAL DEPTH
PLUGGED BACK			
3414	3393	21	Cmnt in 4-1/2" csg.
3393			TOTAL DEPTH - PB
(All measurements taken from top of rotary bushing which is 2' above derrick floor)			
PAY ZONES			
3362	3369	7	Miss. Chat
3378	3385	7	Miss. Chat

RECEIVED
STATE CORPORATION COMMISSION
NOV 22 1968
CONSERVATION DIVISION
Wichita, Kansas

LOCATION					
3300	FEET NORTH OF SOUTH SECTION LINE				
4620	FEET EAST OF WEST SECTION LINE				
1980	FEET SOUTH OF NORTH SECTION LINE				
660	FEET WEST OF EAST SECTION LINE				
NORTH					
SOUTH					
SCALE 2"=1 MILE					
CASING AND CEMENTING RECORD					
SIZE CASING	8-5/8"	4-1/2"			
THREAD	8 rd	8 rd			
WEIGHT	28#	11#			
GRADE	J-55	J-55			
CONDITION	A	A			
SET AT	253'	3413'			
BACKS CEMENT	275	135			
SIZE OF HOLE	12-1/4"	7-7/8"			
Temp. survey 9-30-61 indicated top of cement returns behind 4-1/2" casing to be at 2900'.					
LINER RECORD					
SIZE	WT.	COND.	LENGTH	BLANK	PERF. SET AT
GUN PERFORATING RECORD					
DATE	CASING	FROM	TO	SIZE SHOTS	NO. SHOTS
10-3-61	4-1/2"	3362	3369	Jet	28
1-25-62	4-1/2"	3378	3385	Jet (C & C)	28
SHOT OR ACID RECORD					
DATE	TOP	BOTTOM	SHOT-ACID	REMARKS	
10-4-61	3362	3369	500G MA		
1-26-62	3378	3385	500G MA		
DRILLING: COMMENCED 9-23-61 COMPLETED 9-29-61					
ELECTRICAL SURVEY BY (1) DATE					
DRILLED WITH (Gabbert & Jones) Rotary TOOLS					
DRILLED IN WITH (Gabbert & Jones) Rotary TOOLS					
FIRST PROD. - NAT. DATE None HRS. BBLs. OIL					
WATER H CU. FT. GAS LBS. ROCK PRESS.					
FIRST PROD. AFTER ACID DATE 10-4-61 HRS. 10 BBLs. OIL					
WATER 750 H CU. FT. GAS CP700-TP500					
GAS/OIL RATIO - POTENTIAL 1930M CFD. Gas					
GRAVITY - TEMP. - GRADE -					
(1) Schlumberger (Sonic & Laterolog 3414) 9-29-61 McCullough (Correlation 3393) 10-3-61					
DATE ABANDONED - SOLD					