


STATE OF KANSAS  
 STATE CORPORATION COMMISSION  
 Give All Information Completely  
 Make Required Affidavit  
 Mail or Deliver Report to:  
 Conservation Division  
 State Corporation Commission  
 800 Bitting Building  
 Wichita, Kansas

15.009.00967.00.00  
 WELL PLUGGING RECORD

OR  
 FORMATION PLUGGING RECORD

Strike out upper line  
 when reporting plug-  
 ging off formations.

NORTH

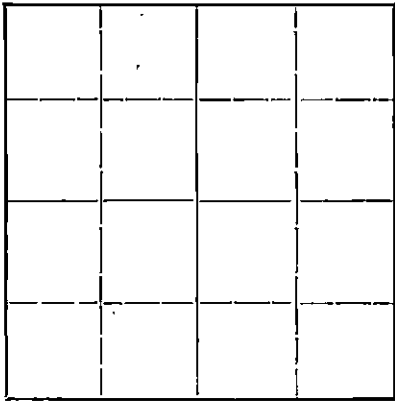

Locate well correctly on above  
 Section Plat

Barton County, Sec. 24 Twp. 17S Rge. 12W (E) (W)

Location as "NE 1/4 NW 1/4 SW 1/4" or footage from lines... NE NE  
 Lease Owner... George F. Johnston and C.R. Pigott  
 Lease Name... F. Beran Well No. 1  
 Office Address... 610 Orpheum Bldg., Wichita, Kansas.  
 Character of Well (completed as Oil, Gas or Dry Hole)... Dry.  
 Date, well completed... January 31, 1941  
 Application for plugging filed... Feb. 2, 1941  
 Application for plugging approved... Feb. 3, 1941  
 Plugging Commenced... Feb. 4, 1941  
 Plugging Completed... Feb. 6, 1941  
 Reason for abandonment of well or producing formation... Dry.

If a producing well is abandoned, date of last production... NONE  
 Was permission obtained from the Conservation Division or its agents before plugging was com-  
 menced? Yes.

Name of Conservation Agent who supervised plugging of this well... B.T. Alexander  
 Producing formation... None Depth to top... Bottom... Total Depth of Well... 3367 Feet  
 Show depth and thickness of all water, oil and gas formations.

OIL, GAS OR WATER RECORDS


CASING RECORD

| Formation                | Content | From | To | Size | Put In | Pulled Out |
|--------------------------|---------|------|----|------|--------|------------|
| (See attached well log.) |         |      |    |      |        |            |



Describe in detail the manner in which the well was plugged, indicating where the mud fluid was placed and the method or methods used in introducing it into the hole. If cement or other plugs were used, state the character of same and depth placed, from... feet to ... feet for each plug set.

Filled with mud from 3367 to 3335, and cement from 3320 and mud from 3045; cement from 3045 to 3030 and from mud from 3030 to 345; dumped 15 sacks of cement, and mud from 345 to 14 feet, and cement to 8 feet and cement to surface.

(see report of B.T. Alexander).

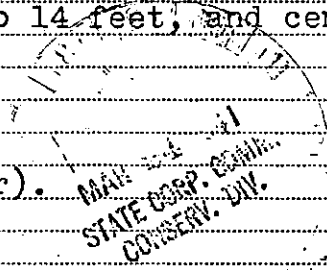

pd.  
 3/19/41  
 H.A.

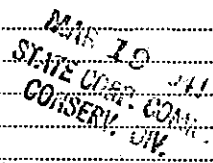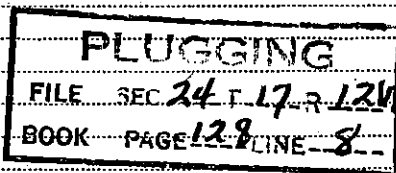

(If additional description is necessary, use BACK of this sheet)

Correspondence regarding this well should be addressed to... Howard D. Brunson  
 Address... 610 Orpheum Bldg., Wichita, Kansas

STATE OF Kansas, COUNTY OF Sedgwick, ss.

H.D. Brunson, member of owner (owner or operator) of the above-described well, being first duly sworn on oath, says: That I have knowledge of the facts, statements, and matters herein contained and the log of the above-described well as filed and that the same are true and correct. So help me God.

(Signature) H.D. Brunson

610 Orpheum Bldg., Wichita, Kansas.  
 (Address)

SUBSCRIBED AND SWORN to before me this 22nd day of March, 1941

M. Irene Black  
 Notary Public.


My commission expires January 13, 1945

PIGOTT AND JOHNSTON.  
 F. Beran No. 1

SEC. 24 T. 17 R. 12W.  
 CE $\frac{1}{2}$  NE NE

Total Depth. 3367  
 Comm. 12-23-40 Comp. 1-31-41  
 Shot or Treated.  
 Contractor. Benson Drilling Co.  
 Issued. 2-8-41

County Barton.

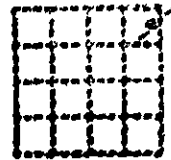

CASING.

15 $\frac{1}{4}$ " 106'  
 10" 700'  
 8 $\frac{1}{4}$ " 2057'  
 6 $\frac{5}{8}$ " 3123'

Elevation.

Production. DRY.

Figures Indicate Bottom of Formations.

|                 |      |                |      |                         |          |
|-----------------|------|----------------|------|-------------------------|----------|
| cellar          | 0    | shale blue     | 1870 | shale                   | 2600     |
| clay yellow     | 20   | lime           | 1880 | lime                    | 2770     |
| sdv shale red   | 60   | red rock       | 1883 | $\frac{1}{2}$ BW 2725   |          |
| sand            | 80   | lime           | 1905 | shale                   | 2775     |
| shale blue      | 90   | shale          | 1922 | lime                    | 2795     |
| red rock        | 110  | lime           | 1935 | shale                   | 2805     |
| shale grey      | 120  | shale          | 1945 | lime                    | 2947     |
| shale           | 360  | red rock       | 1950 | shale                   | 2950     |
| sand            | 370  | lime           | 1965 | lime                    | 2954     |
| shale           | 420  | shale          | 1975 | shale                   | 2965     |
| red rock ( 2 BW | 430  | lime           | 1990 | lime                    | 2975     |
| sdv shale (490) | 510  | shale          | 2000 | shale                   | 2980     |
| 15 BW 695       |      | lime           | 2025 | red rock                | 2985     |
| red rock        | 695  | red rock       | 2035 | shale                   | 3030     |
| lime            | 725  | lime           | 2095 | lime                    | 3039     |
| red rock        | 940  | shale          | 2100 | shale                   | 3047     |
| shale grey      | 990  | red rock       | 2105 | lime                    | 3070     |
| red rock        | 1025 | lime           | 2125 | shale                   | 3080     |
| shale grey      | 1140 | shale          | 2135 | lime                    | 3180     |
| shale           | 1150 | lime           | 2140 | show oil 3116-3122      |          |
| salt            | 1430 | lime           | 2195 | water with it. Show oil |          |
| shale           | 1440 | shale          | 2205 | 3210-3215               |          |
| lime            | 1450 | shale          | 2245 | shale                   | 3187     |
| shale           | 1455 | lime           | 2255 | lime                    | 3300     |
| lime            | 1465 | shale          | 2275 | conglomerate            | 3335     |
| shale           | 1470 | lime           | 2285 | lime (arbuckle)         | 3367 HFW |
| lime            | 1480 | shale          | 2295 | Total Depth.            |          |
| shale brown     | 1485 | lime           | 2310 |                         |          |
| lime            | 1505 | shale          | 2320 | Top Salt 1150           |          |
| shale           | 1525 | lime           | 2330 |                         |          |
| shale           | 1545 | shale          | 2348 |                         |          |
| lime            | 1570 | lime           | 2350 |                         |          |
| shale           | 1580 | shale          | 2355 |                         |          |
| lime            | 1590 | shale & shells | 2390 |                         |          |
| shale           | 1600 | lime           | 2420 |                         |          |
| lime            | 1615 | shale          | 2450 |                         |          |
| shale           | 1640 | lime           | 2460 |                         |          |
| red rock        | 1660 | shale          | 2465 |                         |          |
| lime            | 1685 | lime           | 2475 |                         |          |
| shale blue      | 1700 | shale          | 2480 |                         |          |
| lime 4 BW 1760  | 1800 | lime           | 2485 |                         |          |
| shale           | 1810 | shale          | 2490 |                         |          |
| lime            | 1840 | lime           | 2505 |                         |          |
| shale           | 1845 | shale          | 2510 |                         |          |
| lime            | 1855 | lime           | 2550 |                         |          |
| lime            | 1860 | shale          | 2570 |                         |          |

