


STATE OF KANSAS
STATE CORPORATION COMMISSION

Give All Information Completely
Make Required Affidavit
Mail or Deliver Report to:
Conservation Division
State Corporation Commission
800 Bitting Building
Wichita, Kansas

15.009.00199.00.00
WELL PLUGGING RECORD

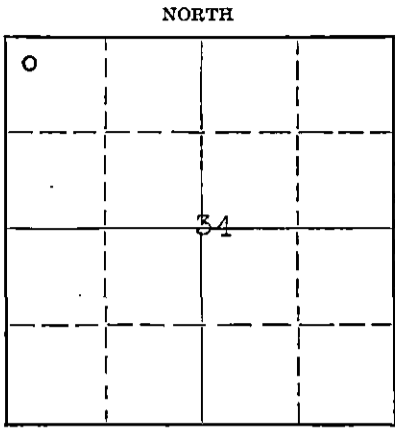

Locate well correctly on above Section Plat

Barton County, Sec. 34 Twp. 17 Rge. 15 ~~W~~ W (W)
Location as "NE/CNW $\frac{1}{4}$ SW $\frac{1}{4}$ " or footage from lines NW NW NW
Lease Owner Northern Pump Company
Lease Name Hampel Well No. 1
Office Address Box 94, Great Bend, Kansas
Character of Well (completed as Oil, Gas or Dry Hole) Dry Hole
Date well completed April 17 19 53
Application for plugging filed May 7 19 53
Application for plugging approved May 8 19 53
Plugging commenced May 11 19 53
Plugging completed May 12 19 53
Reason for abandonment of well or producing formation Dry Hole

If a producing well is abandoned, date of last production 19...
Was permission obtained from the Conservation Division or its agents before plugging was commenced? Yes

Name of Conservation Agent who supervised plugging of this well C. D. Stough
Producing formation None Depth to top Bottom Total Depth of Well 3556 Feet
Show depth and thickness of all water, oil and gas formations.

OIL, GAS OR WATER RECORDS

CASING RECORD

Formation	Content	From	To	Size	Put In	Pulled Out
Topeka	2993 - 990			8-5/8"	1050'	None
Heebner Shale	3226 - 1223			5-1/2"	3544'	2622'
Brown Lime	3289 - 1286					
Base Ks. City	3480 - 1477					
Conglomerate	3520 - 1517					
Arbuckle	3535 - 1532					

Describe in detail the manner in which the well was plugged, indicating where the mud fluid was placed and the method or methods used in introducing it into the hole. If cement or other plugs were used, state the character of same and depth placed, from... feet to... feet for each plug set.

Sand from 3548' (plug back depth) to 3530'
Cement " 3530' to 3490'
Mud from 3490' to 275'
Rock from 275' to 265'
Cement from 265' to 185'
Mud from 185' to 35'
Dumped 10 sacks cement - hole filled to top of surface

5-15-53

RECEIVED
STATE CORPORATION COMMISSION
MAY 15 1953

(If additional description is necessary, use BACK of this sheet)
Name of Plugging Contractor West Supply Company
Address Chase, Kansas

STATE OF Kansas, COUNTY OF Barton, SS.
D. R. Berry (employee of owner) or (owner or operator) of the above-described well,

being first duly sworn on oath, says: That I have knowledge of the facts, statements, and matters herein contained and the log of the above-described well as filed and that the same are true and correct. So help me God.

(Signature) D. R. Berry
Box 94, Great Bend, Kansas
(Address)

SUBSCRIBED AND SWORN to before me this 14 day of May, 19 53.
Beryl Lawrence
Notary Public.

My commission expires April 28, 1957

PLUGGING
WELL SEC 34 T 17 R 15 W
BOOK PAGE 29 LINE 25

