


15.009.00174.00.02

STATE OF KANSAS
STATE CORPORATION COMMISSION

WELL PLUGGING RECORD

Give All Information Completely
Make Required Affidavit
Mail or Deliver Report to
Conservation Division
State Corporation Comm.
245 North Water
Wichita, KS 67202

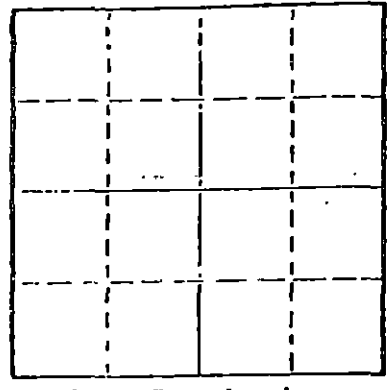

Barton County. Sec. 33 Twp. 17 Rge. 15 NE
Location as "NE/CNW $\frac{1}{4}$ SW $\frac{1}{4}$ " or footage from lines NE/NE/NE
Lease Owner J. C. Musgrove, Inc.
Lease Name SCHRIEBER Well No. 1 (OWWO)
Office Address Box 1362, Great Bend, Kansas 67530
Character of Well (Completed as Oil, Gas or Dry Hole) Old Well Work Over
Date Well completed 19
Application for plugging filed December 23 1976
Application for plugging approved 19
Plugging commenced December 23 1976
Plugging completed December 29 1976
Reason for abandonment of well or producing formation depleted
If a producing well is abandoned, date of last production 19
Was permission obtained from the Conservation Division or its agents before plugging was commenced? yes
Name of Conservation Agent who supervised plugging of this well Duane Rankin
Producing formation Depth to top Bottom Total Depth of Well 3632
Show depth and thickness of all water, oil and gas formations.

OIL, GAS OR WATER RECORDS

CASING RECORD

FORMATION	FROM	TO	SIZE	PUT IN	PULLED OUT
STATE CORPORATION COMMISSION			8 5/8"	1058'	none
			4 1/2"	3585'	2,684.90'

RECEIVED
JAN 07 1977
CONSERVATION DIVISION
Wichita, Kansas

Describe in detail the manner in which the well was plugged, indicating where the mud fluid was placed and the method or methods used in introducing it into the hold. If cement or other plugs were used, state the character of same and depth placed, from feet to feet for each plug set.

Pushed plug to 2981. Dumped in 20 ft. sand and 5 sacks cement.
Shot pipe @ 2920' and 2720'. Pulled a total of 67 joints of 4 1/2" casing.
Pushed plug to 450' and built a rock bridge to 390'.
Plugged well with 6 1/2 yds. ready-mix concrete.

RECEIVED
STATE CORPORATION COMMISSION

JAN 04 1977


CONSERVATION DIVISION
Wichita, Kansas

(If additional description is necessary, use BACK of this sheet)

Name of Plugging Contractor Rockhold Engineering, Inc.
Box 698, Great Bend, Kansas 67530

STATE OF Kansas COUNTY OF Barton ss.
James W. Rockhold (employee of owner) or (owner or operator) of the above-described

well, being first duly sworn on oath, says: That I have knowledge of the facts, statements, and matters herein contained and the log of the above-described well as filed and that the same are true and correct. So help me God.

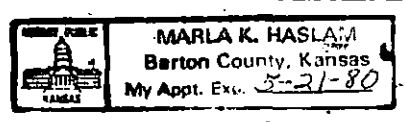

(Signature) James W. Rockhold
Box 698, Great Bend, Kansas 67530
(Address)

Subscribed and Sworn to before me this 3rd day of January, 19 77

My commission expires May 21, 1980 Marla K. Haslam Notary Public.