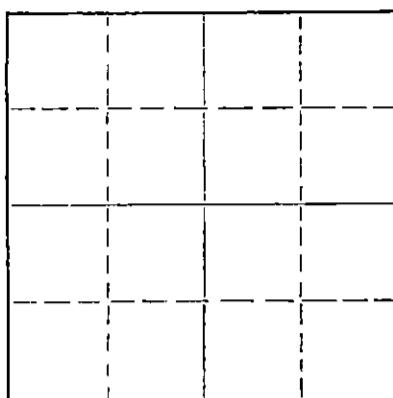


STATE OF KANSAS
STATE CORPORATION COMMISSION

Give All Information Completely
Make Required Affidavit
Mail or Deliver Report to:
Conservation Division
State Corporation Commission
211 No. Broadway
Wichita, Kansas

NORTH

Locate well correctly on above
Section Plat

County. Sec. 33 Twp. 17S Rge. (E) 15 (W)
Location as "NE/CNW&SW&" or footage from lines NE NE NE
Lease Owner Chief Drilling Co., Inc.
Lease Name Schreiber (Washdown) Well No. 1
Office Address Box 797 - Great Bend, Kansas

Character of Well (completed as Oil, Gas or Dry Hole) Dry Hole
Date well completed 11/1 1965
Application for plugging filed 11/1 1965
Application for plugging approved 11/1 1965
Plugging commenced 11/1 1965
Plugging completed 11/1 1965
Reason for abandonment of well or producing formation Dry Hole

If a producing well is abandoned, date of last production 19
Was permission obtained from the Conservation Division or its agents before plugging was commenced? Yes

Name of Conservation Agent who supervised plugging of this well Donald Turan - Russell, Kansas
Producing formation Depth to top Bottom Total Depth of Well 3645 Feet
Show depth and thickness of all water, oil and gas formations.

OIL, GAS OR WATER RECORDS

CASING RECORD

FORMATION	CONTENT	FROM	TO	SIZE	PUT IN	PULLED OUT
Hole originally drilled by John B. Hawley in 1952.	surface casing was set when hole was originally drilled and said casing is still set and cemented in hole.			1055' of 8-5/8"		

Describe in detail the manner in which the well was plugged, indicating where the mud fluid was placed and the method or methods used in introducing it into the hole. If cement or other plugs were used, state the character of same and depth placed, from _____ feet to _____ feet for each plug set.

1/4 sack hulls & wooden plug set @ 400'
Mixed 25 sacks cement through drill pipe
1/4 sack hulls & wooden plug set @ 40'
Mixed 10 sacks cement through drill pipe

RECEIVED
STATE CORPORATION COMMISSION

NOV 8 1965

CONSERVATION DIVISION
Wichita, Kansas

(If additional description is necessary, use BACK of this sheet)

Name of Plugging Contractor Chief Drilling Co., Inc.
Address Box 797 - Great Bend, Kansas

STATE OF KANSAS, COUNTY OF BARTON, ss.
V. Richard Hoover, President (employee of owner) or (owner or operator) of the above-described well, being first duly sworn on oath, says: That I have knowledge of the facts, statements, and matters herein contained and the log of the above-described well as filed and that the same are true and correct. So help me God. CHIEF DRILLING CO., INC.

(Signature) V. Richard Hoover
Box 797 Great Bend, Kansas

(Address)

SUBSCRIBED AND SWEARN TO before me this 2nd day of November, 1965

Carmen R. Cook

Carmen R. Cook,

Notary Public.

My commission expires Jan. 26, 1967