

15.009.20662.00.00


STATE OF KANSAS
STATE CORPORATION COMMISSION

Give All Information Completely
Make Required Affidavit
Mail or Deliver Report to:
Conservation Division
State Corporation Commission
P. O. Box 17027
Wichita, Kansas 67217
NORTH

WELL PLUGGING RECORD

Barton County. Sec. 18 Twp. 17 Rge. (E) 15 (W)

Location as "NE/CNW/SW" or footage from lines NE SW NE
Lease Owner Addis Oil Operations
Lease Name Stos Well No. 1
Office Address Box 519, Great Bend, Kansas 67530
Character of Well (completed as Oil, Gas or Dry Hole) oil
Date well completed _____ 19____
Application for plugging filed April 25 19 73
Application for plugging approved _____ 19____
Plugging commenced April 25 19 73
Plugging completed May 4 19 73
Reason for abandonment of well or producing formation depleted

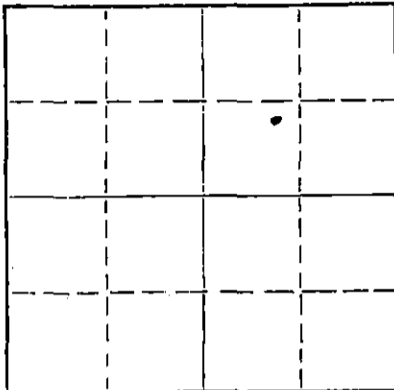

Locate well correctly on above
Section Plat

If a producing well is abandoned, date of last production _____ 19____
Was permission obtained from the Conservation Division or its agents before plugging was commenced? yes

Name of Conservation Agent who supervised plugging of this well Donald Truan
Producing formation _____ Depth to top _____ Bottom _____ Total Depth of Well 3573 Feet
Show depth and thickness of all water, oil and gas formations.

OIL, GAS OR WATER RECORDS

CASING RECORD

FORMATION	CONTENT	FROM	TO	SIZE	PUT IN	PULLED OUT
		0	1081	8 5/8"	1081	none
			3569 1/2	5 1/2"	3569 1/2	2617.86

Describe in detail the manner in which the well was plugged, indicating where the mud fluid was placed and the method or methods used in introducing it into the hole. If cement or other plugs were used, state the character of same and depth placed, from _____ feet to _____ feet for each plug set.

Sanded back to 3540' and dumped 5 sacks of cement.

Set 20' rock bridge at 370'. Plugged well with 5 yards of ready mix cement.

RECEIVED
STATE CORPORATION COMMISSION
MAY 8 1973
CONSERVATION DIVISION
Wichita, Kansas

(If additional description is necessary, use BACK of this sheet)
Name of Plugging Contractor PIPE PULLERS, INC.
Address Box 486, Ellinwood, Kansas

STATE OF KANSAS, COUNTY OF BARTON, ss.
Evelyn Roth (employee of owner) or (owner or operator) of the above-described well, being first duly sworn on oath, says: That I have knowledge of the facts, statements, and matters herein contained and the log of the above-described well as filed and that the same are true and correct. So help me God.

(Signature) Evelyn Roth
Ellinwood, Kansas
(Address)

SUBSCRIBED AND SWORN TO before me this 7th day of May 19 73

My commission expires Feb. 10, 1975

George A. Meyer
Notary Public.

W E L L L O G

DATE COMMENCED: March 10, 1972
DATE COMPLETED: March 19, 1972

Tracer Added
SYOS #1
NE/4 SW/4 NE/4
Section 18-T17S-R15W
Barton Co., Ks.

ELEVATION: 2009 K.B.

0 - 70'	Post Rock
70 - 195'	Shale - Shells
195 - 270'	Shale w/Sand streaks
270 - 710'	Sand & Shale
710 - 1067'	Red Bed
1067 - 1098'	Anhydrite
1098 - 1780'	Red Bed - Shale
1780 - 2938'	Shale - Lime
2938 - 2988'	Lime
2988 - 3007'	Shale - Sand
3007 - 3240'	Lime
3240 - 3244'	Shale
3244 - 3258'	Lime - Shale
3258 - 3272'	Lime
3272 - 3304'	Shale
3304 - 3536'	Lime
3536 - 3545'	Lime - Shale
3545 - 3561'	Cherty Congl.
3561 - 3573'	Dolomite

FORMATION DATA

Anhydrite	1067
Howard	2938
Severy	2988
Topoka	3007
Heebner	3240
Toronto	3258
Douglas	3272
Lansing	3304
Base K.C.	3536
Cherty Congl.	3545
Arbuckle	3561
RTD	3573

Surface Pipe: Set now 20' 8-5/8" surface pipe at 3081' with 425 sacks cement.

Production Casing: Set used 5 1/2", 14.5# casing at 3560 1/2' with 15 bbls. salt flush & 125 lbs. 60-40 Pozmix, salt sat.

A F F I D A V I T

STATE OF KANSAS
COUNTY OF BARTON) ss.

Leonard Williamson, of lawful age, does state and swear that the facts and statements herein contained are true and correct to the best of his knowledge.

Leonard Williamson

Subscribed and sworn to before me this 22 day of March 1972.

My Commission Expires:

April 11, 1974

Robert M. Hagler
Notary Public

RECEIVED
STATE CORPORATION COMMISSION
APR 27 1973
CONSERVATION DIVISION
Wichita, Kansas