


Give All Information Completely
Make Required Affidavit
Mail or Delivery Report to:
Conservation Division
State Corporation Commission
211 N. Broadway
Wichita, Kansas

15.009.01600.00.00

WELL PLUGGING RECORD

NORTH

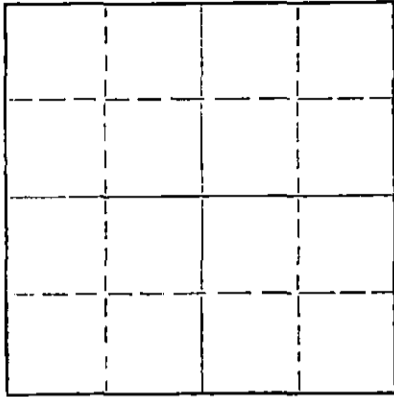

Locate well correctly on above
Section Plat

BARTON County. Sec. 33 Twp. 17 Rge. (E) 14(W)

Location as "NE/CNW*SW*" or footage from lines. NW NW NE
Lease Owner NADEL & GUSSMAN
Lease Name KEENAN Well No. 1
Office Address 625 Union Center Building, Wichita, Kansas
Character of Well (completed as Oil, Gas or Dry Hole) Dry Hole
Date well completed 2-15-63 19__
Application for plugging filed 2-15-63 19__
Application for plugging approved 2-15-63 19__
Plugging commenced 2-15-63 19__
Plugging completed 2-15-63 19__
Reason for abandonment of well or producing formation dry hole

If a producing well is abandoned, date of last production _____ 19__
Was permission obtained from the Conservation Division or its agents before plugging was commenced? yes

Name of Conservation Agent who supervised plugging of this well Donald Truan, Russell, Kansas
Producing formation _____ Depth to top _____ Bottom _____ Total Depth of Well 3406 Feet
Show depth and thickness of all water, oil and gas formations.

OIL, GAS OR WATER RECORDS				CASING RECORD		
FORMATION	CONTENT	FROM	TO	SIZE	PUT IN	PULLED OUT
				8-5/8"	855'	-0-

Describe in detail the manner in which the well was plugged, indicating where the mud fluid was placed and the method or methods used in introducing it into the hole. If cement or other plugs were used, state the character of same and depth placed, from _____ feet to _____ feet for each plug set.

Mud Plug @ 350' w/1/2 sack hulls
Mud Plug @ 40' w/1/2 sack hulls

STATE CORPORATION COMMISSION
FEB 27 1963
2-27-63
CONSERVATION DIV.
Wichita, Kansas

(If additional description is necessary, use BACK of this sheet)
Name of Plugging Contractor K & E DRILLING, INC.
Address 719 Union Center Building, Wichita, Kansas

STATE OF KANSAS, COUNTY OF SEDGWICK, ss.
H. L. Wilson of K & E Drilling

XXX, being first duly sworn on oath, says: That I have knowledge of the facts, statements, and matters herein contained and the log of the above-described well as filed and that the same are true and correct. So help me God.

(Signature) H. L. Wilson
719 Union Center, Wichita, Kansas
(Address)

Subscribed and Sworn to before me this 18th day of February 19 63

My commission expires August 30, 1965
Julene M. Bannon
Notary Public.

DRILLER'S WELL LOG

OPERATOR: NADEL & GUSSMAN
625 Union Center Building
Wichita 2, Kansas

WELL NAME: #1 Keenan
LOCATION: NW NW NE, Sec. 33-17-14
Barton County, Kansas

CONTRACTOR: **K & E DRILLING, INC.**
719 UNION CENTER BLDG.
WICHITA, KANSAS

COMMENCED: 2-7-63

CASING RECORD: 8-5/8" @ 855' w/375 sx.

COMPLETED: 2-15-63

ROTARY TOTAL DEPTH: 3406'

ELEVATION: 1870. DF

PRODUCTION: D & A

FORMATION RECORD

Depths shown indicate bottom of formations encountered.

Shale	240
Shale & Shells	385
Sand	475
Red Bed, Shale & Shells	750
Red Bed	847
Anhydrite	880
Red Bed & Shale	1600
Lime	2140
Lime & Shale	2355
Shale	2605
Lime & Shale	2765
Lime	3406 RTD

RECEIVED
FEB 27 1963
CONSERVATION
Wichita, Kansas

CERTIFICATION

State of KANSAS }
County of SEDGWICK } ss:

I, H. L. Wilson, of K&E DRILLING, INC., upon oath state that the above and foregoing is a true and correct copy of the Driller's Log of the above named well.

H. L. Wilson

H. L. Wilson

Subscribed and sworn to before me this 18th day of February, 1963.

Julene M. Bannon

Julene M. Bannon Notary Public.

My Commission expires: August 30, 1965

