


STATE OF KANSAS  
STATE CORPORATION COMMISSION

Give All Information Completely  
Make Required Affidavit  
Mail or Deliver Report to:  
Conservation Division  
State Corporation Commission  
800 Bittling Building  
Wichita, Kansas

5.009.00824.00.00

WELL PLUGGING RECORD

NORTH

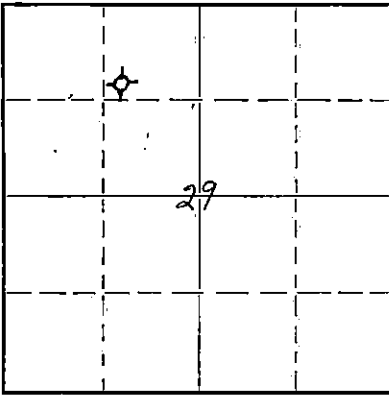

Locate well correctly on above  
Section Plat

Barton County, Sec. 29 Twp. 17 Rge. 14 (E) W. (W)  
Location as "NE/CNW $\frac{1}{4}$ SW $\frac{1}{4}$ " or footage from lines C-SW $\frac{1}{4}$  NE $\frac{1}{4}$  NW $\frac{1}{4}$   
Lease Owner The El Dorado Refining Company.  
Lease Name BOYLE Well No. 1  
Office Address Box 551, El Dorado, Kansas  
Character of Well (completed as Oil, Gas or Dry Hole) Dry Hole  
Date well completed 3-30-19 50  
Application for plugging filed 4-18-19 50  
Application for plugging approved 4-19-19 50  
Plugging commenced 4-24-19 50  
Plugging completed 4-27-19 50  
Reason for abandonment of well or producing formation No Commercial Production

If a producing well is abandoned, date of last production 19  
Was permission obtained from the Conservation Division or its agents before plugging was commenced? Yes

Name of Conservation Agent who supervised plugging of this well C. D. Stough  
Producing formation Arbuckle Depth to top 3388' Bottom 3395' Total Depth of Well 3395' Feet  
Show depth and thickness of all water, oil and gas formations.

OIL, GAS OR WATER RECORDS

CASING RECORD

Formation	Content	From	To	Size	Put In	Pulled Out
				8-5/8"	751'	000
				5 1/2"	3397'	2685.35'

Describe in detail the manner in which the well was plugged, indicating where the mud fluid was placed and the method or methods used in introducing it into the hole. If cement or other plugs were used, state the character of same and depth placed, from.....feet to.....feet for each plug set.

Filled hole with sand from 3395' to 3100'. Run 5 sacks of cement at 3100'. Mudded up to 250' - set bridge and run 15 sacks of cement at 250'. Then mudded up to 25' & run 10 sacks of cement to cap.

MAY 3 - 1950

5-3-50

CONSERVATION  
DIVISION  
KANSAS

(If additional description is necessary, use BACK of this sheet)

Correspondence regarding this well should be addressed to The El Dorado Refining Company  
Address Box 209 - Russell, Kansas


STATE OF KANSAS, COUNTY OF RUSSELL, ss.  
Levi B. Sherman (employee of owner) of the above-described well,  
being first duly sworn on oath, says: That I have knowledge of the facts, statements, and matters herein contained and the log of the above-described well as filed and that the same are true and correct. So help me God.

(Signature) Levi B. Sherman  
Box 209 - Russell, Kansas  
(Address)

SUBSCRIBED AND SWORN to before me this 2 day of May 1950

Verel J. Brack  
Notary Public.

My commission expires 10-13-52

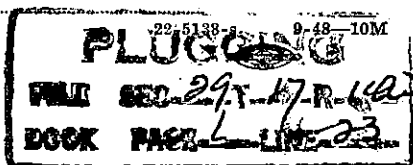

15.009.00824.00.00

STERLING DRILLING COMPANY

STERLING, KANSAS

WELL LOG

BOYLE NO. 1

Location - C SW/4 NE/4 NW/4 of Section 29-17S-14W, Barton County, Kansas.

Owner - El Dorado Refining Company  
Contractor - Sterling Drilling Company

Commenced - 3-17-50  
Completed - 3-30-50 (w/r)

Total Depth - 3395' (w/r)

LOG

0- 60	Surface Clay
60- 337	Shale and Shells
337- 400	Sand and Shale
400- 470	Sand
470- 490	Red Bed
490- 860	Shale and Red Bed
860- 890	Anhydrite
890- 925	Shale and Shells
925-1100	Shale, Shells and Salt
1100-1180	Shale and Lime
1180-1490	Shale and Shells
1490-1635	Shale and Lime
1635-2055	Lime
2055-2820	Shale and Lime
2820-3055	Lime
3055-3060	Shale
3060-3115	Lime and Sandy Shale
3115-3355	Lime
3355-3388	Conglomerate
3388-3395	Arbuckle Lime

CASING RECORD

751 Feet of 8-5/8" Surface Pipe  
Cemented with 500 Sacks Cement

3395 Feet 5 1/2" O.D. Casing  
Cemented with 100 Sacks Cement

**PLUGGING**  
 FILE SEC. 29-17-14W  
 BOOK PAGE 1 LINE 23

MAY 3 - 1950  
 STATE OF KANSAS  
 COMMISSIONER OF GEOL.  
 KANSAS