


WELL PLUGGING RECORD

Give All Information Completely
Make Required Affidavit
Mail or Deliver Report to:
Conservation Division
State Corporation Commission
211 No. Broadway
Wichita, Kansas

NORTH

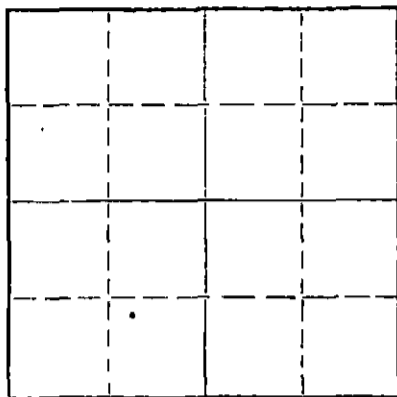

Locate well correctly on above
Section Plat

Barton County. Sec. 13 Twp. 16 Rge. 15 (E) W (W)
Location as "NE/CNW'SW" or footage from lines NW NW NE
Lease Owner Shields Oil Producers, Inc.
Lease Name Strecker "A" Well No. 1
Office Address Shields Bldg., Russell, Kansas
Character of Well (completed as Oil, Gas or Dry Hole) Dry Hole
Date well completed January 25 1966
Application for plugging filed January 25 1966
Application for plugging approved January 25 1966
Plugging commenced January 25 1966
Plugging completed January 25 1966
Reason for abandonment of well or producing formation Dry hole

If a producing well is abandoned, date of last production 19
Was permission obtained from the Conservation Division or its agents before plugging was commenced? Yes

Name of Conservation Agent who supervised plugging of this well Donald Truman
Producing formation _____ Depth to top _____ Bottom _____ Total Depth of Well 3,485 Feet
Show depth and thickness of all water, oil and gas formations.

OIL, GAS OR WATER RECORDS

CASING RECORD

FORMATION	CONTENT	FROM	TO	SIZE	PUT IN	PULLED OUT
				8 5/8"	973'	Cmtd. w/450 sax

Describe in detail the manner in which the well was plugged, indicating where the mud fluid was placed and the method or methods used in introducing it into the hole. If cement or other plugs were used, state the character of same and depth placed, from _____ feet to _____ feet for each plug set.

Fill w/heavy mud to 350'
Set bridge plug @ 350' w/1/4 sax hulls on plug
Dump 30 sax cement on plug thru 4 1/2" drill pipe
Fill w/heavy mud to 40'
Set bridge plug @ 40' w/1/2 sax hulls on plug
Dump 10 sax cement on plug to cellar

RECEIVED
STATE CORPORATION COMMISSION
FEB 3 1966
CONSERVATION DIVISION
Wichita, Kansas

(If additional description is necessary, use BACK of this sheet)

Name of Plugging Contractor Shields Drilling Co., Inc.
Address Shields Bldg., Russell, Kansas

STATE OF Kansas, COUNTY OF Russell, ss.
R. I. Shields (employee of owner) or (owner or operator) of the above-described well, being first duly sworn on oath, says: That I have knowledge of the facts, statements, and matters herein contained and the log of the above-described well as filed and that the same are true and correct. So help me God.

(Signature) R. I. Shields
Shields Bldg., Russell, Kansas
(Address)

SUBSCRIBED AND SWORN TO before me this 1st day of February, 1966

My commission expires May 26, 1967
Luck Phillips
Notary Public.




Shields

15.009. 50352.00 R. 11. Kansas

WELL LOG

Operator: Shields Oil Producers, Inc.
 Well: Strecker "A" #1
 Commenced: January 17, 1966
 Completed: January 25, 1966
 Contractor: Shields Drilling Co., Inc.

Well Description: NW NW NE
 Sec. 13-16S-15W
 Barton Co., Kansas

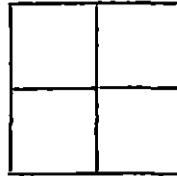

Size	CASING RECORD	
	Run	Pulled
8 5/8"	973'	Cmtd. w/450 sax

Elevation: 1,952' R.B.
 Treatment:

Production: D & A

Tops: Heebner 3,114'
 Lansing-K. C. 3,192'
 Conglomerate 3,420'
 Arbuckle 3,458'

..... Figures Indicate Bottom of Formations

Clay, sand, postrock & shale	265'
Shale & sand	500'
Shale, shells & redbed	963'
Anhydrite	1,000'
Shale, shells & salt	1,300'
Shale & lime	2,025'
Lime	2,300'
Lime & shale	2,825'
Lime	3,485' RTD

NOTES

DST #1 3,047-3,087' Tool open 1 hr. w/weak blow for 15 min.
 Recovered 20' mud. IBHP-865#, IFP-26#,
 FFP-31#, FBHP-43#/20 min.

DST #2 3,350'-3,400' Tool open 20 min. w/weak blow for 8 min.
 Recovered 5' mud. IBHP-760#, IFP-60#,
 FFP-63#, FBHP-437#/20 min.

RECEIVED
 STATE CORPORATION COMMISSION

FEB 3 1966

CONSERVATION DIVISION
 Wichita, Kansas