

STATE OF KANSAS  
STATE CORPORATION COMMISSION

15.009.01351.00.00  
WELL PLUGGING RECORD


Give All Information Completely  
Make Required Affidavit  
Mail or Deliver Report to:  
Conservation Division  
State Corporation Commission  
800 Biting Building  
Wichita, Kansas

FORMATION PLUGGING RECORD

Strike out upper line  
when reporting plugging  
of formations.

Barton County, Sec. 4 Twp. 16S Rge. 15 (E) 15 (W)

Location as "NE $\frac{1}{4}$ NW $\frac{1}{4}$ SW $\frac{1}{4}$ " or footage from lines Center of NE/4 NE/4 SW/4  
Lease Owner Gulf Oil Corporation  
Lease Name Henry Steinert Well No. 1  
Office Address Box 661, Tulsa, Oklahoma  
Character of Well (completed as Oil, Gas or Dry Hole) Dry Hole  
Date well completed April 22, 1942 19  
Application for plugging filed April 21, 1942 19  
Application for plugging approved April 21, 1942 19  
Plugging commenced April 22, 1942 19  
Plugging completed April 22, 1942 19  
Reason for abandonment of well or producing formation Dry Hole

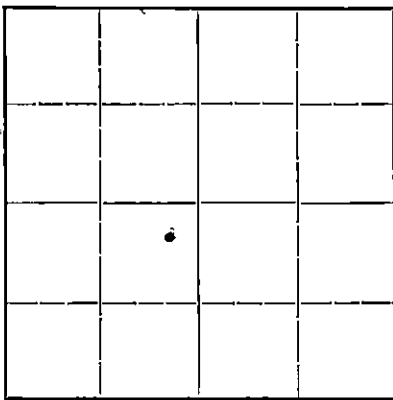

Locate well correctly on above  
Section Plat

If a producing well is abandoned, date of last production - 19  
Was permission obtained from the Conservation Division or its agents before plugging was commenced? Yes

Name of Conservation Agent who supervised plugging of this well C. T. Alexander, Great Bend, Kansas  
Producing formation - Depth to top - Bottom - Total Depth of Well 3595 Feet  
Show depth and thickness of all water, oil and gas formations.

OIL, GAS OR WATER RECORDS

CASING RECORD

Formation	Content	From	To	Size	Put In	Pulled Out
				13"	223'	None

Describe in detail the manner in which the well was plugged, indicating where the mud fluid was placed and the method or methods used in introducing it into the hole. If cement or other plugs were used, state the character of same and depth placed, from feet to feet for each plug set.

Filled hole with heavy mud to 1005'. Cemented thru drill pipe with 25 sacks cement. Cemented 1005 to 940', filled with heavy mud from 940' to 226'. Placed plug at 226', cemented thru drill pipe with 45 sacks from 226 to 155'. Filled with dirt and mud to 26' below bottom of cellar, placed plug and cemented up into cellar with 20 sacks.

PLUGGING  
FILE 4-16-15W  
BOOK PAGE 31 LINE 44

5-1-42

MAILED  
MAY 1 1942  
KANSAS

(If additional description is necessary, use BACK of this sheet)

Correspondence regarding this well should be addressed to Gulf Oil Corporation  
Address Box 661, Tulsa, Oklahoma

STATE OF Kansas, COUNTY OF Rice, ss.  
O. L. Stevenson (employee of owner) of (owner or operator) of the above-described well,  
being first duly sworn on oath, says: That I have knowledge of the facts, statements, and matters herein contained and the log of the above-described well as filed and that the same are true and correct. So help me God.

(Signature) O. L. Stevenson  
Chaw, Kansas (Address)

SUBSCRIBED AND SWORN to before me this 29th day of April, 1942

Jackson E. Watkins  
Notary Public.

My commission expires January 3, 1945