


STATE OF KANSAS
STATE CORPORATION COMMISSION

Form CP-4

15.009.30497.00.00
WELL PLUGGING RECORD

Give All Information Completely
Make Required Affidavit
Mail or Deliver Report to:
Conservation Division
State Corporation Commission
212 No. Market
Wichita, Kansas

NORTH

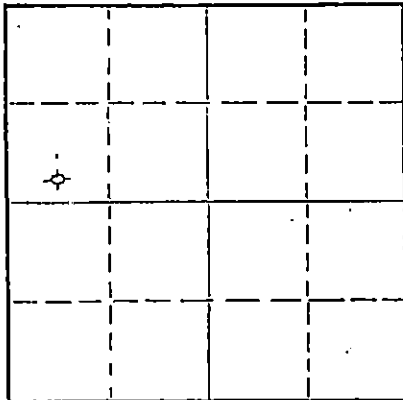

Locate well correctly on above
Section Plat

BARTON County. Sec. 32 Twp. 16S Rge. 14 (E) W (W)
Location as "NE/CNW/SW" or footage from lines C. S/2 SW/4 NW/4
Lease Owner BIRMINGHAM-BARTLETT DRILLING CO.
Lease Name VARAH Well No. 1
Office Address 300 KAUFMAN BLDG., WICHITA, KANSAS 67202
Character of Well (completed as Oil, Gas or Dry Hole) DRY HOLE
Date well completed DECEMBER 19, 19 66
Application for plugging filed (verbal) DECEMBER 19, 19 66
Application for plugging approved (verbal) DECEMBER 19, 19 66
Plugging commenced DECEMBER 19, 19 66
Plugging completed DECEMBER 19, 19 66
Reason for abandonment of well or producing formation DRY HOLE

If a producing well is abandoned, date of last production _____ 19____
Was permission obtained from the Conservation Division or its agents before plugging was commenced? YES

Name of Conservation Agent who supervised plugging of this well DONALD TRUAN
Producing formation _____ Depth to top _____ Bottom _____ Total Depth of Well 3513 Feet
Show depth and thickness of all water, oil and gas formations.

OIL, GAS OR WATER RECORDS

CASING RECORD

FORMATION	CONTENT	FROM	TO	SIZE	PUT IN	PULLED OUT
		0	304'	8-5/8"	304'	none

Describe in detail the manner in which the well was plugged, indicating where the mud fluid was placed and the method or methods used in introducing it into the hole. If cement or other plugs were used, state the character of same and depth placed, from _____ feet to _____ feet for each plug set.

FILLED HOLE WITH MUD TO 290', SET BOTTOM PLUG WITH 1/4 SACK HULLS AND 25 SACKS CEMENT. SET TOP PLUG AT 40' WITH 1/2 SACK HULLS and 10 SACKS CEMENT.

RECEIVED
DEC 21 1966
CONSERVATION DIVISION
WICHITA, KANSAS

(If additional description is necessary, use BACK of this sheet)
Name of Plugging Contractor BIRMINGHAM-BARTLETT DRILLING CO.
Address 300 Kaufman Building, Wichita, Kansas 67202

STATE OF KANSAS COUNTY OF SEDGWICK
RICHARD HINDERY, PARTNER OF BIRMINGHAM-BARTLETT DRILLING CO. OWNER, OPERATOR & CONTRACTOR
(employee of owner) or (owner or operator) of the above-described well, being first duly sworn on oath, says: That I have knowledge of the facts, statements, and matters herein contained and the log of the above-described well as filed and that the same are true and correct. So help me God. BIRMINGHAM-BARTLETT DRILLING CO.
(Signature) RM Richard Hindery Partner
300 Kaufman Building, Wichita, Kansas 67202
(Address)

SUBSCRIBED AND SWORN TO before me this 20th day of December, 19 66.

My commission expires October 2, 1970.

Beverly Larson
Beverly Larson Notary Public.

15 009 30497.00.00

VARAH NO. 1 WELL

LOCATION: Center of the S/2 SW/4 NW/4 Section 32-16S-14W, Barton County, Kansas

SPUCCED: 12-11-66
 DRILLING
 COMPLETED: 12-19-66

OWNER, OPERATOR, and CONTRACTOR: Birmingham-Bartlett Drilling Co. 300 Kaufman Building 212 South Market Wichita, Kansas 67202

SURFACE CASING: 8-5/8" OD 24# casing cemented at 304' with 210 sacks cement.

OIL STRING: None set. Dry hole. Plugged 12-19-66.

LOG

(Figures indicate bottom of formation)

0	40	Shale and sand
	90	Rock
	304	Rock, shale, and sand
	517	Shale and shells
	620	Sand
	974	Red bed
	1008	Anhydrite
	1345	Shale and shells
	1685	Shale
	3070	Lime and shale
	3513	Lime
	3513	Rotary total depth

The undersigned, Richard Hindery, one of the partners of Birmingham-Bartlett Drilling Co., hereby certifies that the above is a true and correct log of the VARAH NO. 1 WELL, as shown in the daily drilling reports.

BIRMINGHAM-BARTLETT DRILLING CO.

By Richard Hindery
Richard Hindery, Partner

subscribed and sworn to before me this 20th day of December, 1966.

Beverly Larson
Beverly Larson, Notary Public

My commission expires October 2, 1970.