


15.009.00847.00.00

WELL PLUGGING RECORD

Give All Information Completely
Make Required Affidavit
Mail or Deliver Report to:
Conservation Division
State Corporation Commission
800 Bittig Building
Wichita, Kansas

NORTH

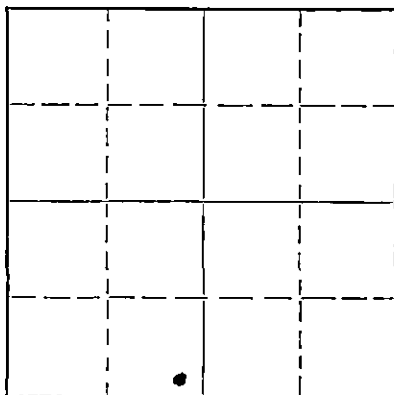

Locate well correctly on above Section Plat

Barton County. Sec. 29 Twp. 16 Rge. 14 (E) W (W)
Location as "NE/CNW $\frac{1}{4}$ SW $\frac{1}{4}$ " or footage from lines SE $\frac{1}{4}$ SE $\frac{1}{4}$ SW $\frac{1}{4}$
Lease Owner Musgrove Petroleum Corporation
Lease Name Poppe Well No. 1
Office Address 407 KFH Building, Wichita, Kansas
Character of Well (completed as Oil, Gas or Dry Hole) Dry Hole
Date well completed August 8, 19 50
Application for plugging filed August 17, 1950 19 50
Application for plugging approved August 10, 1950 19 50
Plugging commenced August 10, 19 50
Plugging completed August 10, 19 50
Reason for abandonment of well or producing formation Dry Hole

If a producing well is abandoned, date of last production 19
Was permission obtained from the Conservation Division or its agents before plugging was commenced?

Name of Conservation Agent who supervised plugging of this well C. D. Stough
Producing formation None Depth to top 3480 Bottom Total Depth of Well 3490 Feet
Show depth and thickness of all water, oil and gas formations.

OIL, GAS OR WATER RECORDS

CASING RECORD

Formation	Content	From	To	Size	Put In	Pulled Out

Describe in detail the manner in which the well was plugged, indicating where the mud fluid was placed and the method or methods used in introducing it into the hole. If cement or other plugs were used, state the character of same and depth placed, from 250 feet to 30 feet for each plug set.

Filled hole with heavy mud from 3488, T.D., to 250 feet. Set Plug at 250 feet and put 15 sacks cement through drill pipe. Filled hole with heavy mud to 30 feet and set plug at 30 feet and dumped 10 sacks cement to cellar base.

AUG 18 1950 8-18-50

(If additional description is necessary, use BACK of this sheet).

Correspondence regarding this well should be addressed to Musgrove Petroleum Corporation
Address 407 KFH Building, Wichita, Kansas

STATE OF KANSAS, COUNTY OF SEDGWICK, ss.
Gordon L. Koelling (employee of owner) or (owner or operator) of the above-described well,
being first duly sworn on oath, says: That I have knowledge of the facts, statements, and matters herein contained and the log of the above-described well as filed and that the same are true and correct. So help me God.

(Signature) Gordon L. Koelling
407 KFH Building (Address)

SUBSCRIBED AND SWORN to before me this 17th day of August, 19 50

My commission expires June 30, 1952 Lucille J. Graywell Notary Public.

PLUGGING
FILE SEC 29 T 16 R 14 E
BOOK PAGE 20 LINE 36

COMPANY: Musgrove Petroleum Corporation, Inc.
 CONTRACTOR: Jackson Drilling Corporation
 FARM: J. Popp, Jr. #1
 LOCATION: SE SE SW Section 29-16-14W,
 Barton County, Kansas
 ELEVATION: 1998
 COMMENCED: July 26, 1950
 COMPLETED: August 8, 1950

0 to 90	Clay
90 to 100	Sand
100 to 360	Shale
360 to 470	Shale and Lime Shells
470 to 535	Sand, Shale and Pyrite
535 to 620	Sand
620 to 658	Lime, Sand and Shale
658 to 984	Redbed
984 to 1010	Anhydrite
1010 to 1390	Redbed, Shale and Shells
1390 to 1670	Redbed, Salt and Shells
1670 to 1710	Shale and Lime
1710 to 1855	Lime
1855 to 1960	Shale and Lime
1960 to 2150	Lime
2150 to 2460	Lime and Shale
2460 to 2500	Shale
2500 to 2627	Shale and Shells
2627 to 2680	Shale
2680 to 2878	Lime and Shale
2878 to 2896	Lime
2896 to 2920	Shale
2920 to 3448	Lime
3448 to 3462	Lime and Shale
3462 to 3474	Conglomerate
3474 to 3480	Sandy Lime, Cherty
3480 to 3490 T.D.	Arbuckle Lime

8 5/8" casing set at 657 feet. Cemented with 350 sacks cement and 3 sacks calcium chloride.

Drill stem test 3222-3252
 Tops: Heebner 3153
 Lansing 3216
 Arbuckle 3484

RECEIVED
 Conservation Div.
 AUG 18 1950
 STATE CORPORATION
 COMMISSION
 KANSAS

PLUGGING
 FILE SEC-29T-16R-14W
 BOOK PAGE-20 LINE-36

Dry

All measurements from top of derrick floor.

C E R T I F I C A T E

I, Harold A. Burt, do hereby certify that the above and foregoing is a true and correct copy of log of the J. Popp, Jr. #1, Section 29-16-14W, Barton County, Kansas, as reflected by files of the Jackson Drilling Corporation.

Harold A. Burt
 Harold A. Burt

Subscribed and sworn to before me, a Notary Public, within and for Johnson County, Kansas, this 11th day of August 1950.

Dorothy J. Wilson
 Dorothy J. Wilson

My Commission Expires November 30, 1950.