


15.009.14200.00.00

WELL PLUGGING RECORD

Give All Information Completely
Make Required Affidavit
Mail or Deliver Report to:
Conservation Division
State Corporation Commission
211 No. Broadway
Wichita, Kansas

NORTH

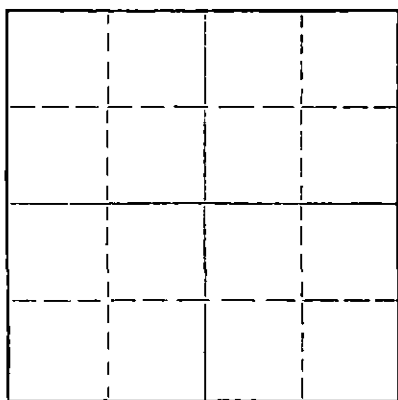

Locate well correctly on above
Section Plat

Barton County. Sec. 5 Twp. 16 Rge. 14 (E) W (W)
Location as "NE/CNW/SW" or footage from lines NE NE SW
Lease Owner Mast Drilling, Inc.
Lease Name Batt Well No. 1
Office Address Russell
Character of Well (completed as Oil, Gas or Dry Hole) Dry Hole
Date well completed 9-24 19 57
Application for plugging filed 9-24 19 57
Application for plugging approved 9-24 19 57
Plugging commenced 9-24 19 57
Plugging completed 9-24 19 57
Reason for abandonment of well or producing formation _____

If a producing well is abandoned, date of last production _____ 19 ____
Was permission obtained from the Conservation Division or its agents before plugging was commenced? yes

Name of Conservation Agent who supervised plugging of this well R. M. Brundage
Producing formation _____ Depth to top _____ Bottom _____ Total Depth of Well 3422 Feet
Show depth and thickness of all water, oil and gas formations.

OIL, GAS OR WATER RECORDS

CASING RECORD

FORMATION	CONTENT	FROM	TO	SIZE	PUT IN	PULLED OUT

Describe in detail the manner in which the well was plugged, indicating where the mud fluid was placed and the method or methods used in introducing it into the hole. If cement or other plugs were used, state the character of same and depth placed, from _____ feet to _____ feet for each plug set.

Stirred up heavy mud. Pumped hole full of heavy mud. Shoved a plug made of gunny sacks and filled with hulls to 330'. Halliburton plug. 20 sacks cement. Heavy mud to 20'. Halliburton plug. 1/2 sack loose hulls. 5 sacks cement.

(If additional description is necessary, use BACK of this sheet)

Name of Plugging Contractor Mast Drilling, Inc.
Address Russell, Kansas

STATE OF Kansas, COUNTY OF Russell, ss. Contractor
James J. Sherman (employee-of-owner) or (owner-or-operator) of the above-described well, being first duly sworn on oath, says: That I have knowledge of the facts, statements, and matters herein contained and the log of the above-described well as filed and that the same are true and correct. So help me God.
(Signature) James J. Sherman
JAMES J. SHERMAN, Secty-Treas.
(Address)

SUBSCRIBED AND SWORN TO before me this 2nd day of October, 19 57
Betty Jean Galyant
Notary Public.

My commission expires 8-9-58

10-3-57

PLUGGING
FILE SEC 5 T 16 R 14W
BOOK PAGE 48 LINE 28

15.009-14200.00.00

WELL LOG

OPERATOR: Mast Drilling, Inc.
Russell, Kansas

CONTRACTOR: Mast Drilling, Inc.
Russell, Kansas

LEASE: Batt #1
NE NE SW
5-16-14W
Barton County, Kansas

COMMENCED: 9-15-57

COMPLETED: 9-24-57

FORMATION	DEPTH
Clay	20
Rock - Sand	140
Shale & Shells	360
Shale	522
Dakota Sand	564
Red Bed	935
Anhydrite	967
Shale & Shells	1350
Salt & Shale	1470
Shale & Shells	1625
Shale & Lime	1820
Lime	2095
Shale & Lime	2275
Shale & Shells	2445
Shale & Lime	2650
Lime & Shale	2775
Lime	3395
Shale	3398
Arbuckle Lime	3422
TOTAL DEPTH	3422

I hereby certify that the above is true and correct to the best of my knowledge.

Mast Drilling, Inc.
James J. Thoman
JAMES J. THOMAN, Secty-Treas.

STATE OF KANSAS)
)ss
COUNTY OF RUSSELL)

Subscribed and sworn to before me this 2nd day of October, 1957.

Betty Jean Galyardt
Notary Public

My Commission expires 8-9-58

PLUGGING
FILE SEC. 5 T. 16 R. 14W
BOOK PAGE 48 LINE 38