


Give All Information Completely
Make Required Affidavit
Mail or Deliver Report to:
Conservation Division
State Corporation Commission
800 Bittling Building
Wichita, Kansas

WELL PLUGGING RECORD

NORTH

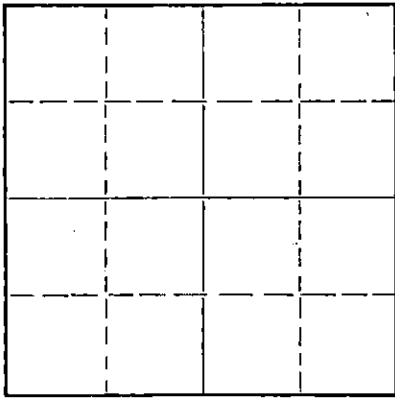

Locate well correctly on above Section Plat

Barton County. Sec. 23 Twp. 16 Rge. 13 (E) W (W)
Location as "NE/CNWxSWx" or footage from lines NW NW NW
Lease Owner Duke & Wood Drilling Company
Lease Name Steiner Well No. 1
Office Address Box 123, Great Bend, Kansas
Character of Well (completed as Oil, Gas or Dry Hole) Dry Hole
Date well completed November 13 1954
Application for plugging filed November 13 1954
Application for plugging approved November 13 1954
Plugging commenced November 13 1954
Plugging completed November 13 1954
Reason for abandonment of well or producing formation Dry

If a producing well is abandoned, date of last production _____ 19____
Was permission obtained from the Conservation Division or its agents before plugging was commenced? Yes

Name of Conservation Agent who supervised plugging of this well Mr. Warren H. Horner
Producing formation _____ Depth to top _____ Bottom _____ Total Depth of Well 3470 Feet
Show depth and thickness of all water, oil and gas formations.

OIL, GAS OR WATER RECORDS

CASING RECORD

FORMATION	CONTENT	FROM	TO	SIZE	PUT IN	PULLED OUT
				8 5/8"	289'	None

Describe in detail the manner in which the well was plugged, indicating where the mud fluid was placed and the method or methods used in introducing it into the hole. If cement or other plugs were used, state the character of same and depth placed, from _____ feet to _____ feet for each plug set.

Filled hole with heavy mud to 275 ft., set bottom plug, dumped 1/2 sack hulls and 20 sacks cement. Set top plug at 35 ft., dumped 1/2 sack hulls and 10 sacks of cement. Filled hole to bottom of cellar.

11-19-54


(If additional description is necessary, use BACK of this sheet)
Name of Plugging Contractor Duke & Wood Drilling Company
Address Box 123, Great Bend, Kansas

STATE OF Kansas, COUNTY OF Barton, ss.
Cecil M. Olson (employee of owner) or (owner or operator) of the above-described well, being first duly sworn on oath, says: That I have knowledge of the facts, statements, and matters herein contained and the log of the above-described well as filed and that the same are true and correct. So help me God.

(Signature) Cecil M. Olson
Great Bend, Kansas
(Address)

SUBSCRIBED AND SWORN TO before me this 17th day of November, 1954
Dean G. Cooley
Notary Public.

My commission expires April 29, 1957

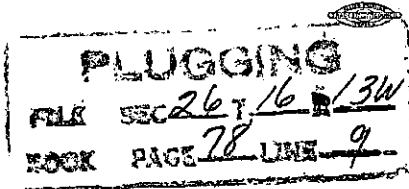

15.009.00458.00.00

WELL LOG
Steiner #1
NW NW NW of 23-16-13W
Barton County, Kansas

Started: 11-2-54
Completed: 11-13-54

Elevation	1922	KB
Anhydrite	864	(-1058)
Heebner	3059	(-1137)
Lansing	3155	(-1233)
Conglomerate	3395	(-1473)
Arbuckle	3445	(-1523)

0-60	Surface clay and post rock
60-210	Blue shale and sand
210-289	Sand and blue shale
289-495	Sand and blue shale
495-864	Red bed
864-893	Anhydrite
893-1200	Shale and shells
1200-1350	Salt and shale
1350-1720	Shale and shells
1720-2100	Lime and shale
2100-2425	Lime and shale
2425-2785	Lime and shale
2785-3140	Lime
3140-3335	Lime
3335-3395	Lime
3395-3445	Conglomerate
3445-3470	Arbuckle
3470	TOTAL ROTARY DEPTH

A F F I D A V I T

STATE OF Kansas, COUNTY OF Barton, SS

I, Lynn O. Duke, of the DUKE & WOOD DRILLING COMPANY being first duly sworn on oath, state; That I have knowledge of the facts, statements and matters herein contained and that the same are true and correct.

Lynn O. Duke
Partner

Subscribed and sworn to before me this 17th day of November, 1954.

Dean E. Hoodiey
Notary Public

My commission expires: April 29, 1957.

PLUGGING
