

STATE OF KANSAS
STATE CORPORATION COMMISSION


Give All Information Completely
Make Required Affidavit
Mail or Deliver Report to:
Conservation Division
State Corporation Commission
800 Bittling Building
Wichita, Kansas

15:009.01331.00.00
WELL PLUGGING RECORD

OR
FORMATION PLUGGING RECORD

Strike out upper line
when reporting plug-
ging off formations.

NORTH

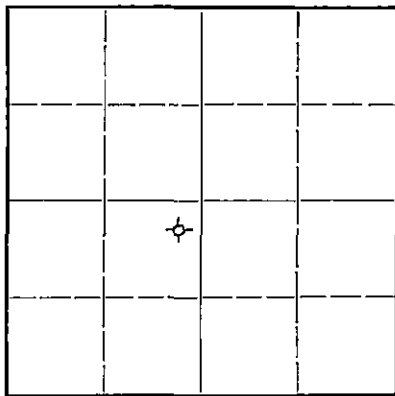

Locate well correctly on above
Section Plat

Barton County. Sec. 35 Twp. 16 Rge. 12 (E) (W)
Location as "NE $\frac{1}{4}$ NW $\frac{1}{4}$ SW $\frac{1}{4}$ " or footage from lines. NE $\frac{1}{4}$ NE $\frac{1}{4}$ SW $\frac{1}{4}$
Lease Owner. Black Marshall Oil Co.
Lease Name. R. Korkisch Well No. 1
Office Address. Great Bend, Kansas
Character of Well (completed as Oil, Gas or Dry Hole). Dry Hole
Date well completed. April 21, 1945 19
Application for plugging filed. April 24, 19 45
Application for plugging approved. April 25 19 45
Plugging commenced. April 21, 1945 19
Plugging completed. April 24, 1945 19
Reason for abandonment of well or producing formation. Dry

If a producing well is abandoned, date of last production. 19
Was permission obtained from the Conservation Division or its agents before plugging was commenced? Yes

Name of Conservation Agent who supervised plugging of this well. H.W. Kerr
Producing formation. None Depth to top. Bottom. Total Depth of Well. 3427' Feet
Show depth and thickness of all water, oil and gas formations.

OIL, GAS OR WATER RECORDS


CASING RECORD

Formation	Content	From	To	Size	Put In	Pulled Out
Sand	Water	190'	200'	12 $\frac{1}{2}$ "	460'	460'
Sand	Water	400'	430'	10"	798'	798'
				8 5/8"	2535'	2535'
				7"	3161'	3161'
				5 $\frac{1}{2}$ "	3369'	3369'

Describe in detail the manner in which the well was plugged, indicating where the mud fluid was placed and the method or methods used in introducing it into the hold. If cement or other plugs were used, state the character of same and depth placed, from _____ feet to _____ feet for each plug set.

Dumped 6-Sacks of cement in bottom of hole, Run heavy mud to 225', Hole bridged at 225' and 15- sacks of cement run on top of bridge, then hole filled with heavy mud to 15', then 15 sacks of cement was run to bottom of cellar and cellar cemented.

35 16 12W
10 line 41

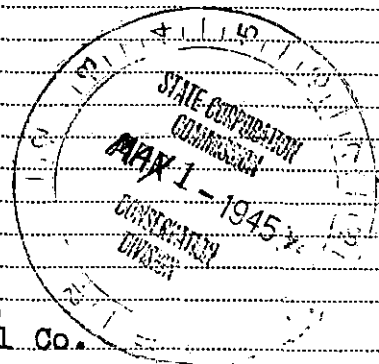

(If additional description is necessary, use BACK of this sheet)

Correspondence regarding this well should be addressed to Black Marshall Oil Co.
Address. Great Bend, Kansas.

STATE OF Kansas, COUNTY OF Barton, ss.
Walter C Roberts (employee of owner) or (owner or operator) of the above-described well,
being first duly sworn on oath, says: That I have knowledge of the facts, statements, and matters herein contained and the log of the above-described well as filed and that the same are true and correct. So help me God.

(Signature) Walter C. Roberts
Clafin, Kansas
(Address)

SUBSCRIBED AND SWORN to before me this 28th day of April, 19 45

My commission expires February 5, 1947

Edwin Wojdziaf
Notary Public.

15.009.01331.00.00

BLACK-MARSHALL OIL CO.

1910 Broadway
GREAT BEND, KANSAS

April 30, 1945

State Corporation Commission
Conservation Division
800 Bitting Building
Wichita 2, Kansas

Gentlemen:

We enclose Well Plugging Record, together with log, covering our R. Korkisch #1 located in the NE NE SW Section 35-16S-12W, Barton County, Kansas.

Yours very truly

BLACK-MARSHALL OIL COMPANY


Leon E. Huff

mlh
Enclosures - 2

35 16 12W
10 41

