


STATE OF KANSAS  
STATE CORPORATION COMMISSION

15.009.00376.00.00  
WELL PLUGGING RECORD

Give All Information Completely  
Make Required Affidavit  
Mail or Deliver Report to:  
Conservation Division  
State Corporation Commission  
800 Bitting Building  
Wichita, Kansas

Barton County, Sec. 32 Twp. 16 Rge. 16/12 (W)

NORTH

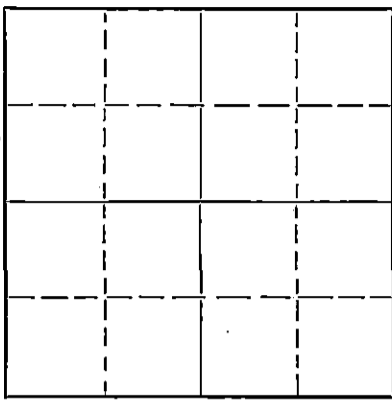

Locate well correctly on above  
Section Flat

Location as "NE/CNW $\frac{1}{4}$ SW $\frac{1}{4}$ " or footage from lines SW SW SE  
Lease Owner J. Bergman  
Lease Name Schneweis Well No. 1  
Office Address 300 Bitting Bldg., Wichita, Kansas  
Character of Well (completed as Oil, Gas or Dry Hole) Oil  
Date well completed 19...  
Application for plugging filed 6-18-51 19...  
Application for plugging approved 6-18-51 19...  
Plugging commenced 6-21-51 19...  
Plugging completed 6-21-51 19...  
Reason for abandonment of well or producing formation Depleted Oil

If a producing well is abandoned, date of last production 19...  
Was permission obtained from the Conservation Division or its agents before plugging was commenced? Yes

Name of Conservation Agent who supervised plugging of this well M. A. Rives  
Producing formation Depth to top Bottom Total Depth of Well 3108 Feet  
Show depth and thickness of all water, oil and gas formations.

OIL, GAS OR WATER RECORDS

CASING RECORD

Formation	Content	From	To	Size	Put In	Pulled Out

Describe in detail the manner in which the well was plugged, indicating where the mud fluid was placed and the method or methods used in introducing it into the hole. If cement or other plugs were used, state the character of same and depth placed, from feet to feet for each plug set.

8 5/8 172' circulated with cement  
5 5/8 3,104' cemented 75 sacks  
filled with sant. to 3100', ran 5 sacks cement.  
Mud to 160', set bridge, ran 15 sacks cement, mud  
to 35', set bridge, ran 10 sacks cement. cap.

RECEIVED  
STATE CORPORATION COMMISSION  
JUL 18 1951  
CONSERVATION DIVISION  
Wichita, Kansas

(If additional description is necessary, use BACK of this sheet)

Name of Plugging Contractor J. Bergman  
Address 300 Bitting Bldg., Wichita, Kansas

STATE OF Kansas, COUNTY OF Sedgwick, ss.  
Jay Bergman (employee of owner) or (owner or operator) of the above-described well,  
being first duly sworn on oath, says: That I have knowledge of the facts, statements, and matters herein contained and the log of the above-described well as filed and that the same are true and correct. So help me God.

(Signature) Jay Bergman  
300 Bitting Bldg., Wichita, Kansas (Address)

SUBSCRIBED AND SWORN to before me this 18th day of July 19 51  
Seward Greiler Notary Public.

My commission expires My Commission Expires Jan. 31, 1953

PLUGGING  
FILED SEC 32 T 16 R 20  
BOOK PAGE 88 LINE 39

23-8390-s 6-51-20M

DRILLERS LOG

Operator: Bergman Oil Co.  
Lease: Schneeweis #1  
Contractor: Honaker Drilling Co., Inc.

	From	To
Top soil & Shale	0	50
Shale & Shells	50	100
Sand	100	130
Shale	130	132
Shale & Shells	132	171

Run 0 joints (172.05') 8-5/8" surface casing, cemented w/125 sacks cement and 1 sack CaCl.

Shale & Red Bed	171	395
Sand	395	455
Shale & Shells	455	545
Shale & Red Bed	545	640
Shale & Shells	640	800
Red Bed	800	839
Anhydrite	839	863
Shale & Shells	863	933
Shale & Red Bed	933	1160
Shale, Shells, Salt	1160	1410
Shale & Shells	1410	1497
Lime	1497	1765
Shale & Lime	1765	1846
Lime	1846	1960
Shale & Lime	1960	2030
Shale & Lime	2030	2933
Lime	2833	3408

T. D.

Run 105 joints 5 1/2" OD 14" seamless casing, set on bottom w/75 sacks cement.

The above is correct to the best of my knowledge.

HONAKER DRILLING CO., INC.

By Joe J. Honaker  
President

Subscribed and sworn to before me this 27th Day of April, 1951.

My commission Expires 9-1-54

L. E. Laraway  
Notary Public  
Barton County, Kansas

**PLUGGING**  
FILE SEC 34 I 16 R 142  
BOOK PAGE 88 LINE 39

COPY