


Give All Information Completely  
Make Required Affidavit  
Mail or Deliver Report to:  
Conservation Division  
State Corporation Commission  
211 No. Broadway  
Wichita, Kansas

WELL PLUGGING RECORD

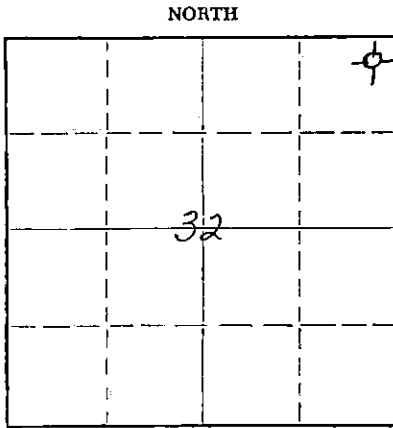

Locate well correctly on above  
Section Plat

Rice County. Sec. 32 Twp. 21 Rge. 8 ~~XX~~ (W)  
Location as "NE/CNW&SW&W" or footage from lines NE NE NE  
Lease Owner Buick Drilling Inc.  
Lease Name Yeakel Well No. 1  
Office Address 600 East 30th, Hutchinson, Kansas  
Character of Well (completed as Oil, Gas or Dry Hole) Dry Hole  
Date well completed 8-19 19 62  
Application for plugging filed 8-21 19 62  
Application for plugging approved (verbal) 8-19 19 62  
Plugging commenced 8-19 19 62  
Plugging completed 8-19 19 62  
Reason for abandonment of well or producing formation dry

If a producing well is abandoned, date of last production 19  
Was permission obtained from the Conservation Division or its agents before plugging was commenced? yes

Name of Conservation Agent who supervised plugging of this well Gilbert J. Toman  
Producing formation \_\_\_\_\_ Depth to top \_\_\_\_\_ Bottom \_\_\_\_\_ Total Depth of Well 3622' Feet  
Show depth and thickness of all water, oil and gas formations.

OIL, GAS OR WATER RECORDS

CASING RECORD

| FORMATION | CONTENT | FROM | TO | SIZE   | PUT IN | PULLED OUT |
|-----------|---------|------|----|--------|--------|------------|
|           |         |      |    | 8 5/8" | 214    | None       |
|           |         |      |    |        |        |            |
|           |         |      |    |        |        |            |
Describe in detail the manner in which the well was plugged, indicating where the mud fluid was placed and the method or methods used in introducing it into the hole. If cement or other plugs were used, state the character of same and depth placed, from \_\_\_\_\_ feet to \_\_\_\_\_ feet for each plug set.

Bottom plug at 214 feet filled hole w/20 sacks cement.

Top plug at 40' filled with 8 sacks cement to 4' below ground level.

2 Sacks cement in rat hole.

RECEIVED  
STATE CORPORATION COMMISSION  
AUG 23 1962  
CONSERVATION DIVISION  
Wichita, Kansas

(If additional description is necessary, use BACK of this sheet)

Name of Plugging Contractor Buick Drilling Inc.  
Address 600 East 30th, Hutchinson, Kansas

STATE OF Kansas, COUNTY OF Reno, ss.  
Buick Drilling Inc. (employee of owner) or (owner or operator) of the above-described well, being first duly sworn on oath, says: That I have knowledge of the facts, statements, and matters herein contained and the log of the above-described well as filed and that the same are true and correct. So help me God.

(Signature) *Buick*  
600 East 30th, Hutchinson, Kansas  
(Address)

SUBSCRIBED AND SWORN TO before me this 21 day of August, 19 62

My commission expires November 16, 1965  
Wilma A. Clark Notary Public



## WELL LOG

Well #1  
 Yeakel NE NE NE  
 Sec. 32-21-8  
 Rice County, Kansas

Company: Buick Drilling Inc. et al  
 Commenced: August 7, 1962  
 Completed: August 19, 1962  
 Casing: 8 5/8" set at 214-175 sks.  
 Elevation: 1649 D. F.-1640 Ground

## Depth:

0- 73  
 73- 214  
 214- 500  
 500-1110  
 1110-1185  
 1185-1195  
 1195-1450  
 1450-1470  
 1470-2595  
 2595-2770  
 2770-2900  
 2900-3239  
 3239-3270  
 3270-3290  
 3290-3347  
 3347-3377  
 3377-3487  
 3487-3552  
 3552-3577  
 3577-3635

## Formation:

Sand  
 Sand & surface soil  
 Sand & shale  
 Shale & shells  
 Lime  
 Andydrite  
 Lime  
 Shale & shells  
 Lime & shale  
 Lime  
 Lime & shale  
 Lime  
 Lime & shale & chert  
 Lime & chert  
 Lime & shale  
 Shale  
 Lime & shale  
 Lime  
 Lime & sand  
 Lime

RECEIVED  
 STATE CORPORATION COMMISSION

AUG 23 1962

CONSERVATION DIVISION  
 Wichita, Kansas

3622 Drillers Log Corrected by Electric Log

D. & A.

I, H. R. Buick, President of Buick Drilling Inc., certify that this is a true and correct copy of the Driller's Log according to the records of this office.

  
 H. R. Buick-President  
 Buick Drilling Inc.

Subscribed and sworn before me, a Notary Public, this 21st day of August, 1962.

My Commission expires  
November 16, 1965

  
 Wilma A. Clark