

STATE OF KANSAS
STATE CORPORATION COMMISSION


WELL PLUGGING RECORD

OR

FORMATION PLUGGING RECORD

Strike out upper line
when reporting plug-
ging off formations.Give All Information Completely
Make Required Affidavit
Mail or Deliver Report to:
Conservation Division
State Corporation Commission
800 Bittling Building
Wichita, Kansas

NORTH

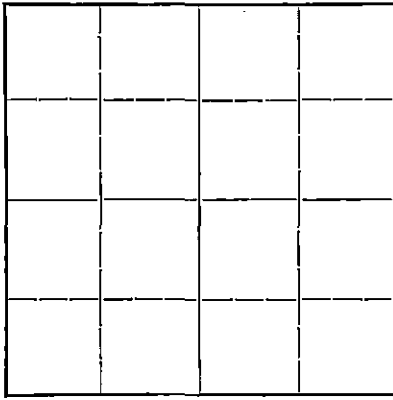Locate well correctly on above
Section Plat

Rice

County. Sec. 17 Twp. 21 Rge. (E) 6 (W)

Location as "NE $\frac{1}{4}$ NW $\frac{1}{4}$ SW $\frac{1}{4}$ " or footage from lines... Can. 50' 7 1/2'

Lease Owner W. L. Hartman et al

Lease Name Brothers Well No. 1

Office Address Box 54 Wichita, Kansas

Character of Well (completed as Oil, Gas or Dry Hole) Dry Hole

Date, well completed June 9 1941 19

Application for plugging filed July 3rd 19 41

Application for plugging approved June 19, 1941 - letter 19

Plugging Commenced July 5th 19 41

Plugging Completed July 7th 19 41

Reason for abandonment of well or producing formation Dry

If a producing well is abandoned, date of last production 19

Was permission obtained from the Conservation Division or its agents before plugging was commenced? Yes agent

Name of Conservation Agent who supervised plugging of this well Ruel Slurkee

Producing formation Depth to top Bottom Total Depth of Well 35 45 Feet

Show depth and thickness of all water, oil and gas formations.

OIL, GAS OR WATER RECORDS

CASING RECORD


Formation	Content	From	To	Size	Put In	Pulled Out
				10 in.	137	Left in
Chat	Slain	35 30	35 35	5 1/2 O.D.	35 30	3023-40
Chat	water	35 37	35 45			

Describe in detail the manner in which the well was plugged, indicating where the mud fluid was placed and the method or methods used in introducing it into the hole. If cement or other plugs were used, state the character of same and depth placed, from... feet to ... feet for each plug set.

Filled from 35 45 to 35 30 with crushed rock
 Dumped six sacks of cement filled hole to 35 25
 Mud from 35 25 to 35 37 drove plug dumped cement
 to 1 1/2 ft mud to 14 ft and dumped six sacks of cement
 in base of cellar

5 1/2 O.D. casing at 35 30 cemented with 100 sacks

10' Surface casing at 137 cemented with 125 sacks
 Surface casing left in.

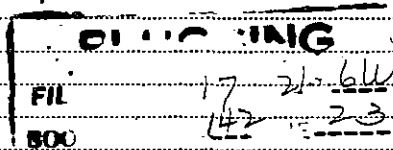

(If additional description is necessary, use BACK of this sheet)

Correspondence regarding this well should be addressed to W. L. Hartman, Box 54, Wichita, Kans.

Address

STATE OF KANSAS, COUNTY OF SEDGWICK, ss.

(employee of owner) or (owner or operator) of the above-described well,
 being first duly sworn on oath, says: That I have knowledge of the facts, statements, and matters herein contained and the log of the above-
 described well as filed and that the same are true and correct. So help me (God)

(Signature) Leo J. Benney

718 Menard Winfield Kan

(Address)

SUBSCRIBED AND SWORN to before me this 23rd day of July, 1941

E. J. Schaefer

Notary Public.

My commission expires Feb. 16, 1942

BROTHERS # 1

NE $\frac{1}{4}$

Company: W. L. Hartman
 Contractor: Pem Drilling Company, Inc.
 Commenced: May 21, 1941
 Completed: June 9, 1941

Location: N $\frac{1}{2}$ NW $\frac{1}{4}$ /17-21-6W
 Rice County, Kansas
 Casing Record: 138' - 10"
 3530' - 5"

40	sandy clay	2448	shale - lime
105	sand - red rock	2525	lime
138	shale shells	2750	lime
215	shale - shells	2850	lime - shale
300	shale - shells	2890	soft lime
425	sandy shale	2895	lime
710	shale - salt	2932	shale
725	shale - shells	2950	lime - shale
825	shale	2984	lime - hard shale - top K.C.
935	salt - shale	3074	lime
1020	shale - shells	3090	lime - soft
1210	lime	3110	lime
1270	hard sand - shale	3128	base of K.C. lime
1280	shale	3145	lime - shale
1340	lime	3175	lime - shale
1370	lime	3224	lime
1405	broken sandy lime	3242	sandy lime
1510	lime	3278	lime
1625	shale	3308	shale
1700	lime - shale	3494	shale - lime
1720	lime	3502	shale
1775	lime	3511	red rock
1795	shale	3523	conglomerate
1840	shale - lime	3530	red shale - chat
1875	shale	3537	chat - total depth Rotary
1955	sandy shale	3540	water - sand - T.D.
2095	shale		
2160	shale		
2188	lime		
2202	shale		
2210	lime - broken		
2240	shale - lime		
2340	shale		
2350	shale		
2390	lime		
2420	sandy shale		
2425	lime		
2435	lime		

Plugged and Abandoned.

I hereby certify that the above is a true and correct record of the formations penetrated in the drilling of the Brothers # 1 well located in the N $\frac{1}{2}$ NW $\frac{1}{4}$ of Section 17-21-6W, Rice County, Kansas.

NE $\frac{1}{4}$

Subscribed and sworn to before
 me this ____ day of July, 1941.

 Notary Public

My commission expires Dec. 20, 1944.

