


STATE OF KANSAS
STATE CORPORATION COMMISSION

Form CP-4

Give All Information Completely
Make Required Affidavit
Mail or Deliver Report to:
Conservation Division
State Corporation Commission

WELL PLUGGING RECORD

P. O. Box 17027
Wichita, Kansas 67217
NORTH

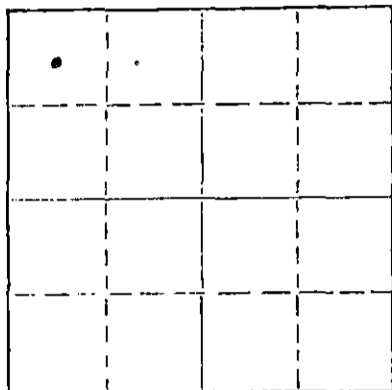

Locate well correctly on above
Section Plat

Rice County, Sec. 30 Twp. 21 Rge. (E) 7 (W)
Location as "NE/CNW/SW" or footage from lines C NW NW
Lease Owner Isern-Wells Bull Creek
Lease Name Ora Swartz Well No. 1
Office Address Box 486, Ellinwood, Kansas 67526
Character of Well (completed as Oil, Gas or Dry Hole) oil
Date well completed _____ 19____
Application for plugging filed Sept. 5 19 74
Application for plugging approved _____ 19____
Plugging commenced Sept. 20 19 74
Plugging completed Sept. 24 19 74
Reason for abandonment of well or producing formation depleted

If a producing well is abandoned, date of last production _____ 19____
Was permission obtained from the Conservation Division or its agents before plugging was commenced? yes

Name of Conservation Agent who supervised plugging of this well Gilbert Toman
Producing formation _____ Depth to top _____ Bottom _____ Total Depth of Well 3477 Feet
Show depth and thickness of all water, oil and gas formations.

OIL, GAS OR WATER RECORDS

CASING RECORD

FORMATION	CONTENT	FROM	TO	SIZE	PUT IN	PULLED OUT
		0	269'	8 5/8"	269'	none
			3476'	5 1/2"	3476'	2749.05

Describe in detail the manner in which the well was plugged, indicating where the mud fluid was placed and the method or methods used in introducing it into the hole. If cement or other plugs were used, state the character of same and depth placed, from _____ feet to _____ feet for each plug set.

Sanded back to 3150' and dumped 4 sacks of cement.
Set 20' rock bridge at 250' and plugged well with 3 1/2 yards of ready mix cement.

RECEIVED
STATE CORPORATION COMMISSION
OCT 2 1974
CONSERVATION DIVISION
Wichita, Kansas

Name of Plugging Contractor PIPE PULLERS, INC.
Address Box 128, Ellinwood, Kansas 67526

STATE OF KANSAS COUNTY OF BARTON, ss.
Evelyn Roth (employee of owner) or (owner-or-operator) of the above-described

well, being first duly sworn on oath, says: That I have knowledge of the facts, statements, and matters herein contained and the log of the above-described well as filed and that the same are true and correct. So help me God.

(Signature) Evelyn Roth
Ellinwood, Kansas (Address)

Subscribed and Sworn to before me this 30th day of September, 19 74

JENNY KASSELMAN
NOTARY PUBLIC
BARTON COUNTY, KANSAS
MY COMM. EXP. JULY 16, 1978

Jenny Kaszelman
Notary Public.

My commission expires _____

