


WELL PLUGGING RECORD

Give All Information Completely
Make Required Affidavit
Mail or Deliver Report to:
Conservation Division
State Corporation Commission
212 North Market, Finance Bldg.
Wichita, Kansas

NORTH

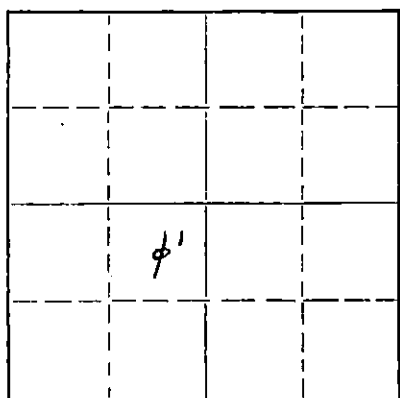

Locate well correctly on above Section Plat

Rice County, Sec. 30 Twp. 21S Rge. (E) 7(W)
Location as "NE/CNW/SW" or footage from lines Center NE-SW
Lease Owner The Pure Oil Company
Lease Name L. A. Schartz Well No. 1
Office Address Box 9545 - Oklahoma City, Oklahoma.
Character of Well (completed as Oil, Gas or Dry Hole) Dry Hole
Date well completed Sept. 1st 19 61
Application for plugging filed Sept. 5th 19 61
Application for plugging approved Verbally approved Sept. 1st 19 61
Plugging commenced Sept. 2nd 19 61
Plugging completed Sept. 2nd 19 61
Reason for abandonment of well or producing formation Dry Hole

If a producing well is abandoned, date of last production 19
Was permission obtained from the Conservation Division or its agents before plugging was commenced? Yes

Name of Conservation Agent who supervised plugging of this well Cecil Jones
Producing formation None Depth to top Bottom Total Depth of Well Feet
Show depth and thickness of all water, oil and gas formations.

OIL, GAS OR WATER RECORDS

CASING RECORD

FORMATION	CONTENT	FROM	TO	SIZE	PUT IN	PULLED OUT
None				8-5/8"	274'	274'

Describe in detail the manner in which the well was plugged, indicating where the mud fluid was placed and the method or methods used in introducing it into the hole. If cement or other plugs were used, state the character of same and depth placed, from feet to feet for each plug set.

Filled hole with rotary mud to 240' from surface. Dumped 1/2 sack cottonseed hulls @ 240' then dumped 20 sacks cement on hulls, filling 8-5/8" casing to 177' from surface. Filled with rotary mud to 40' from surface. Dumped 1/2 sack cottonseed hulls @ 40' then dumped 10 sacks cement on hulls filling 8-5/8" casing to surface. Screwed steel cap on 8-5/8" casing.

STATE CORPORATION COMMISSION
SEP 8 1961
CONSERVATION DIVISION
Wichita, Kansas

(If additional description is necessary, use BACK of this sheet)
Name of Plugging Contractor Gabbert & Jones Drilling Company
Address 514 Orpheum Bldg., Wichita, Kansas.

STATE OF Oklahoma, COUNTY OF Oklahoma, ss.
I, J. J. Wasicek (employee of owner) or (owner or operator) of the above-described well, being first duly sworn on oath, says: That I have knowledge of the facts, statements, and matters herein contained and the log of the above-described well as filed and that the same are true and correct. So help me God.

(Signature) J. J. Wasicek
Box 9545 - Oklahoma City, Oklahoma (Address)

SUBSCRIBED AND SWORN to before me this 7th day of September, 19 61

John L. Stalard
Notary Public.

My commission expires 4/14/64

GABBERT-JONES DRILLING CO., INC.
 WICHITA, KANSAS
 DRILLERS WELL LOG

RECEIVED
 STATE CORPORATION COMMISSION
 SEP 3 1961
 CONSERVATION DIVISION
 Wichita, Kansas

L. A. SCHARTZ #1
 C NE SW SECTION 30-21S-7W
 RICE COUNTY, KANSAS

COMMENCED: AUGUST 25, 1961
 COMPLETED: SEPTEMBER 2, 1961

OPERATOR - THE PURE OIL COMPANY

DEPTH		FORMATION	REMARKS
FROM	To		
0	80	SAND	
80	278	RED BED	RAN 266.4' OF 8-5/8" CASING, SET @ 274' W/300 SACKS CEMENT.
278	1190	SHALE	
1190	1450	SHALE & LIME	
1450	1865	LIME	
1865	2430	SHALE	
2430	2630	SHALE & LIME	
2630	3520	LIME	
3520	TD		DRY & ABANDONED

I, E. E. HALL, CERTIFY THIS TO BE A TRUE AND CORRECT COPY OF THE DRILLER'S LOG FOR THE WELL DRILLED IN C NE SW SECTION 30-21S-7W, RICE COUNTY, KANSAS, TO THE BEST OF MY KNOWLEDGE AND BELIEF.

E. E. Hall

E. E. HALL

STATE OF KANSAS)
) SS
 COUNTY OF SEDGWICK)

BEFORE ME, THE UNDERSIGNED, A NOTARY PUBLIC WITHIN AND FOR SAID COUNTY AND STATE, ON THIS 5TH DAY OF SEPTEMBER, 1961, PERSONALLY APPEARED E. E. HALL TO ME PERSONALLY KNOWN TO BE THE IDENTICAL PERSON WHO EXECUTED THE WITHIN AND FOREGOING INSTRUMENT AND ACKNOWLEDGED TO ME THAT HE EXECUTED THE SAME AS HIS FREE AND VOLUNTARY ACT AND DEED FOR THE USES AND PURPOSES THEREIN SET FORTH.

IN WITNESS WHEREOF, I HAVE HEREUNTO SET MY HAND AND OFFICIAL SEAL THE DAY AND YEAR LAST ABOVE WRITTEN.

Vira A. McKenzie
 VIRA A. MCKENZIE, NOTARY PUBLIC

MY COMMISSION EXPIRES OCTOBER 2, 1963.