


WELL PLUGGING RECORD

Give All Information Completely
Make Required Affidavit
Mail or Deliver Report to:
Conservation Division
State Corporation Commission
211 No. Broadway
Wichita, Kansas

NORTH

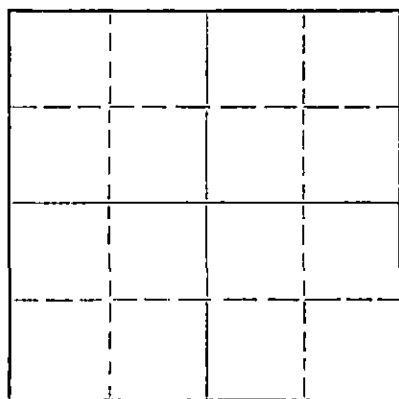

Locate well correctly on above
Section Plat

Rice County. Sec. 29 Twp. 21 Rge. 7 (E) W (W)
Location as "NE/CNW/SW" or footage from lines NE NE SE
Lease Owner Francis M. Raymond
Lease Name Wilt Well No. I
Office Address Wichita, Kansas
Character of Well (completed as Oil, Gas or Dry Hole) Dry Hole
Date well completed 8/20/56 19
Application for plugging filed 8/20/56 19
Application for plugging approved 8/20/56 19
Plugging commenced 8/20/56 19
Plugging completed 8/20/56 19
Reason for abandonment of well or producing formation Dry Hole

If a producing well is abandoned, date of last production _____ 19____
Was permission obtained from the Conservation Division or its agents before plugging was commenced? Yes

Name of Conservation Agent who supervised plugging of this well Ruel Durkee
Producing formation _____ Depth to top _____ Bottom _____ Total Depth of Well 3448 Feet
Show depth and thickness of all water, oil and gas formations.

OIL, GAS OR WATER RECORDS

CASING RECORD

FORMATION	CONTENT	FROM	TO	SIZE	PUT IN	PULLED OUT
		0	214	8 5/8	214	none

Describe in detail the manner in which the well was plugged, indicating where the mud fluid was placed and the method or methods used in introducing it into the hole. If cement or other plugs were used, state the character of same and depth placed, from _____ feet to _____ feet for each plug set.

Plugged hole - set bridge @ 205 that held 7 jts. of drill pipe - put 15 sks. cement through 6 jts. of drill pipe - filled hole to 19' with heavy mud - set rock & hull bridge @ 19' - filled with cement to bottom of cellar.

(If additional description is necessary, use BACK of this sheet)

Name of Plugging Contractor Francis M. Raymond
Address 204-A Insurance Bldg Wichita, Kansas

STATE OF KANSAS COUNTY OF SEDGWICK ss.
Chas. W. Raymond (employee of owner) or (owner or operator) of the above-described well, being first duly sworn on oath, says: That I have knowledge of the facts, statements, and matters herein contained and the log of the above-described well as filed and that the same are true and correct. So help me God.

(Signature) Chas W Raymond
204-A Insurance Bldg. Wichita, Kansas
(Address)

SUBSCRIBED AND SWORN to before me this 27 day of August, 1956

Mary Ellen [Signature]
Notary Public.

My commission expires July 8, 1957

PLUGGING
FILE SEC. 29 T. 21 R. 7W
BOOK PAGE 92 LINE 18

8-28-56

Francis M. Raymond
Wilt #1

NE NE SE 29-21-7W
Rice County, Kansas

Total Depth: 3448

Elevation: 1613 K.B.

Comm: 8/8/56
Comp: 8/20/56

Casing:
8 5/8" @ 214

Cement:
175 sacks common
2 cc

Figures indicate bottom of formation

10	surface soil	<u>TOPS</u>	
110	sand & gravel		
420	shells, sand & red bed	Heebner	2751
570	shells & shale	Douglas	2770
780	shale, shells & sand	Br. Lime	2922
1100	lime & shale breaks	Lan. K. C.	2946
1300	shale & shells	B/K. C.	3310
1340	lime & shale	Miss. Chert	3448
1415	shale & shells		
1570	lime		
1610	shale & shells		
1850	shale & lime		
2060	shale & shells		
2245	shale & lime		
2485	shale & shells		
2765	lime & shale		
2801	shale		
2830	sand		
2930	sand & lime		
3340	lime		
3399	lime & shaly cong.		
3404	lime		
3407	shale		
3448	lime		

STATE OF KANSAS)
) ss.
COUNTY OF SEDGWICK)

I hereby certify that the above information is true and correct to the best of my knowledge.

Chas W Raymond

Subscribed and sworn to before me this 27th day of August, 1956.

Mary Ellen Cummins
Notary Public

My commission expires: July 8, 1957

RECEIVED
STATE GOVERNMENT COMMISSION
AUG 29 1956
CONSERVATION DIVISION
Wichita, Kansas

PLUGGING
FILE SEC. 29 T. 21 R. 7W
BOOK PAGE 92 LINE 18