


WELL PLUGGING RECORD

Give All Information Completely
Make Required Affidavit
Mail or Deliver Report to:
Conservation Division
State Corporation Commission
800 Bittling Building
Wichita, Kansas

Barton County, Sec. 23 Twp. 17 Rge. 11 (E) (W)

Location as "NE/CNW $\frac{1}{4}$ /SW $\frac{1}{4}$ " or footage from lines NW NE NE
Lease Owner National Cooperative Refinery Association
Lease Name Disque "A" Well No. 2
Office Address 820 Union National Bank Building
Character of Well (completed as Oil, Gas or Dry Hole) Dry Hole
Date well completed March 18, 1952
Application for plugging filed March 18, 1952
Application for plugging approved March 19, 1952
Plugging commenced March 19, 1952
Plugging completed March 19, 1952
Reason for abandonment of well or producing formation _____

NORTH

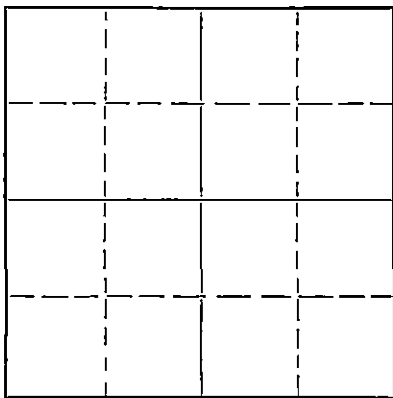

Locate well correctly on above
Section Plat

If a producing well is abandoned, date of last production _____ 19____
Was permission obtained from the Conservation Division or its agents before plugging was commenced? Yes

Name of Conservation Agent who supervised plugging of this well Mr. C. D. Stough, Great Bend, Kansas
Producing formation _____ Depth to top _____ Bottom _____ Total Depth of Well 3386 Feet
Show depth and thickness of all water, oil and gas formations.

OIL, GAS OR WATER RECORDS

CASING RECORD

Formation	Content	From	To	Size	Put In	Pulled Out
				8 5/8"	217'	Cemented

Describe in detail the manner in which the well was plugged, indicating where the mud fluid was placed and the method or methods used in introducing it into the hole. If cement or other plugs were used, state the character of same and depth placed, from _____ feet to _____ feet for each plug set.

Filled hole with heavy mud from total depth to 270', pushed plug down to 270', cemented thru open end of drill pipe with 50 sacks. By Glove Cementing Co.,
Filled hole with heavy mud to 35', pushed plug down to 35', dumped 10 sacks cement on up to base of cellar.

3-21-52

MAR 21 1952
CONSERVATION DIVISION
WICHITA, KANSAS

(If additional description is necessary, use BACK of this sheet)

Name of Plugging Contractor West Supply Company
Address Chase, Kansas

STATE OF Kansas, COUNTY OF Sedgwick, ss.
W. Jean La Coss (employee of owner) or (owner or operator) of the above-described well,
being first duly sworn on oath, says: That I have knowledge of the facts, statements, and matters herein contained and the log of the above-described well as filed and that the same are true and correct. So help me God.

(Signature) W. Jean La Coss

820 Union National Bank Building
(Address)

SUBSCRIBED AND SWORN TO before me this 20 day of March, 1952

I. A. Lange
Notary Public.

My commission expires February 20, 1953

23-8390-s 6-51-20M

PLUGGING
FILE SEC 23 T 17 R 11 W
BOOK PAGE 2 LINE 35

15.009.06393.00.00

NATIONAL COOPERATIVE REFINERY ASSOC. ET AL

Wichita, Kansas

Farm: Disque #2

Approx. Center NW NE NE
Section 23-17-11
Barton County, Kansas

Commenced RD: 3/6/52
Completed RD: 3/18/52
Total Depth : 3386'

Elevation:
Initial Prod:
Contractor: Pam-Kar Drlg. Co., Inc.

Casing: 217' 8 1/8" O.D. 24# 8rd thd

STRATA	DEPTH
Surface soil and clay	70
Clay & shale	110
Shale & shells	265
Shale & Redbed	285
Sand, Shale & Pyrite	415
Redbeds & Shale	652
Anhydrite	678
Redbeds & shale	900
Shale & redbed	955
Shale & shells	1080
Salt & shale	1150
Shale & shells	1525
Broken Lime	1825
Lime	1875
Broken Lime	2035
Shale & lime	2554
Lime & shale	3309
Lime, shale, chirt	3378
Lime	3386
Total Depth	3386

I hereby certify that the above is a true and correct log of said well as reflected by the daily drilling reports.

PAM-KAR DRILLING COMPANY, INC.
By

R. B. McLaughlin
R. B. McLaughlin, Sec.-Treas.

Signed, and sworn to in my presence this 27th day of March, 1952, by R. B. McLaughlin, secretary-treasurer of the Pam-Kar Drilling Company, Inc., a corporation in the State of Kansas.

Edmund C. Combs
Notary Public

My commission expires September 23, 1953.

RECEIVED
A.R.C.M.
ATTORNEY
WICHITA, KANSAS

PLUGGING
FILE SEC 23 T 17 R 110
BOOK PAGE 2 LINE 35

STATE OF KANSAS

INVOICE

March 20, 1952 19

To: Nat'l. Cooperative Refinery Ass'n.
820 Union Nat'l. Bank Bldg.
Wichita, Kansas

STATE CORPORATION COMMISSION

CONSERVATION DIVISION

800 BITTING BUILDING
WICHITA, KANSAS

FOR: plugging ASSESSMENT AS FOLLOWS:

Disque "A" Well No. #2
NW NE NE 23-17-11W
Barton County
File No. 2-35

\$25.00

NOTE: We also need a WELL LOG and a WELL PLUGGING RECORD on this well to complete our file.

30368

PR

3-28-52

92 C-37

RETURN THIS COPY WITH REMITTANCE



DETACH FROM CHECK BEFORE DEPOSITING

VOUCHER NO.

3-279

THE ABOVE CHECK IS IN FULL SETTLEMENT OF THE ITEMS LISTED BELOW. IF NOT CORRECT PLEASE RETURN ALL PAPERS

NATIONAL COOPERATIVE REFINERY ASSOCIATION

Nº

30368

Invoice dated March 20, 1952

\$25.00