


STATE OF KANSAS
STATE CORPORATION COMMISSION

Give All Information Completely
Make Required Affidavit
Mail or Deliver Report to:
Conservation Division
State Corporation Commission
211 No. Broadway
Wichita, Kansas

15.009.00482.00.01
WELL PLUGGING RECORD

NORTH

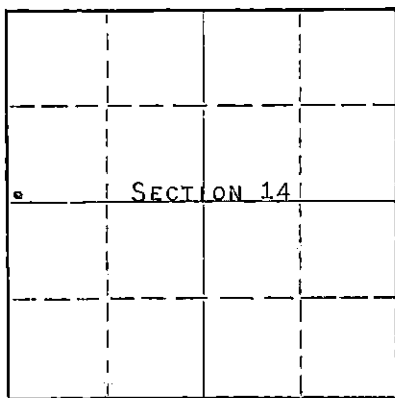

Locate well correctly on above
Section Plat

BARTON County. Sec. 14 Twp. 16 Rge. 15W (#) X(W)

Location as "NE/CNW/SW" or footage from lines SW SW NW

Lease Owner PETROLEUM, INC.

Lease Name KARST Well No. 1

Office Address ROUTE 2, GREAT BEND, KANSAS

Character of Well (completed as Oil, Gas or Dry Hole) DRY HOLE

Date well completed JULY 3, 19 62

Application for plugging filed JULY 3, 19 62

Application for plugging approved JULY 3, 19 62

Plugging commenced JULY 3, 19 62

Plugging completed JULY 3, 19 62

Reason for abandonment of well or producing formation NO PRODUCIBLE FORMATIONS.

If a producing well is abandoned, date of last production NONE 19

Was permission obtained from the Conservation Division or its agents before plugging was commenced? YES

Name of Conservation Agent who supervised plugging of this well DON TRUAN

Producing formation Depth to top Bottom Total Depth of Well 3542' Feet

Show depth and thickness of all water, oil and gas formations.

OIL, GAS OR WATER RECORDS

CASING RECORD

FORMATION	CONTENT	FROM	TO	SIZE	PUT IN	PULLED OUT
				8-5/8"	200'	NONE

Describe in detail the manner in which the well was plugged, indicating where the mud fluid was placed and the method or methods used in introducing it into the hole. If cement or other plugs were used, state the character of same and depth placed, from feet to feet for each plug set.

MUDDING UP WITH HEAVY MUD TO 300' FOLLOWED BY WOODEN PLUG.
PLACED 20 SACKS CEMENT THROUGH DRILL PIPE ONTO PLUG. MUDDING
UP WITH HEAVY MUD TO 190', FOLLOWED BY WOODEN PLUG AND 1/4
SACK HULLS. PLACED 20 SACKS CEMENT THROUGH DRILL PIPE ONTO HULLS.
MUDDING UP WITH HEAVY MUD TO 35' FOLLOWED BY 1/2 SACK HULLS AND 10
SACKS CEMENT TO BASE OF WELL CELLAR.

NOTE: WELL WAS WASHDOWN, ORIGINALLY DRILLED BY NADEL &
GUSSMAN IN OCTOBER, 1950. "WELL LOG" SHOULD HAVE
BEEN FILED BY NADEL & GUSSMAN.

RECEIVED
STATE CORPORATION COMMISSION
JUL 11 1962
CONSERVATION DIVISION
Wichita, Kansas

(If additional description is necessary, use BACK of this sheet)

Name of Plugging Contractor GARVEY DRILLING COMPANY
Address ROUTE 2, GREAT BEND, KANSAS

STATE OF KANSAS, COUNTY OF BARTON, ss.

DON SEARLE (employee of owner) or (owner or operator) of the above-described well, being first duly sworn on oath, says: That I have knowledge of the facts, statements, and matters herein contained and the log of the above-described well as filed and that the same are true and correct. So help me God. DON SEARLE, DIST. PROD. SUPT.

(Signature)

ROUTE 2, GREAT BEND, KANSAS
(Address)

SUBSCRIBED AND SWORN to before me this 9TH day of JULY, 19 62

My commission expires APRIL 14, 1963.

Notary Public.