

STATE OF KANSAS
STATE CORPORATION COMMISSION


Give All Information Completely
Make Required Affidavit
Mail or Deliver Report to:
Conservation Division
State Corporation Commission
800 Biting Building
Wichita, Kansas

15.009.06358.00.00
WELL PLUGGING RECORD

OR
FORMATION PLUGGING RECORD

Strike out upper line
when reporting plug-
ging off formations.

NORTH

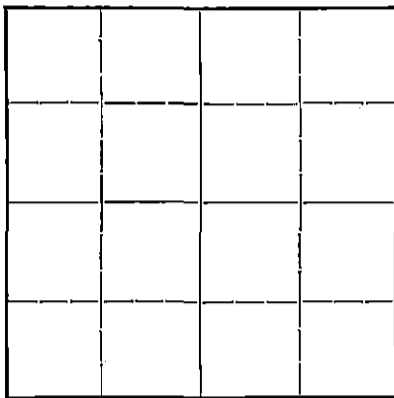

Locate well correctly on above
Section Plat

Barton County, Sec. 5 Twp. 16 Rge. (E) 12 (W)
Location as "NE $\frac{1}{4}$ NW $\frac{1}{4}$ SW $\frac{1}{4}$ " or footage from lines. SW $\frac{1}{4}$ SE $\frac{1}{4}$
Lease Owner Hinkle Oil Company
Lease Name Depiesse Well No. 1
Office Address 919 Union National Bank Bldg., Wichita, Kansas.
Character of Well (completed as Oil, Gas or Dry Hole) Dry Hole
Date, well completed. 10-30-41 19
Application for plugging filed. 10-30-41 19
Application for plugging approved. 10-30-41 19
Plugging Commenced. 10-30-41 19
Plugging Completed. 10-30-41 19
Reason for abandonment of well or producing formation. Dry

If a producing well is abandoned, date of last production. 19
Was permission obtained from the Conservation Division or its agents before plugging was com-
menced? Yes

Name of Conservation Agent who supervised plugging of this well. C. T. Alexander
Producing formation. Depth to top. Bottom. Total Depth of Well. 3393 Feet
Show depth and thickness of all water, oil and gas formations.

OIL, GAS OR WATER RECORDS

CASING RECORD


Formation	Content	From	To	Size	Put In	Pulled Out
Surface pipe				10"	108'	

Describe in detail the manner in which the well was plugged, indicating where the mud fluid was placed and the method or methods used in introducing it into the hole. If cement or other plugs were used, state the character of same and depth placed, from.....feet to.....feet for each plug set.

Total depth 3393'

Hole filled with mud from 3391 to 275 ft.
Permanent Bridge placed at 275 feet
Cemented with 10 sacks cement
mud to 30 feet
cement to 8 ft.
mud to top of surface

PLUGGING
FILE 15-16-R-122
BOOK PAGE 13 LINE 3

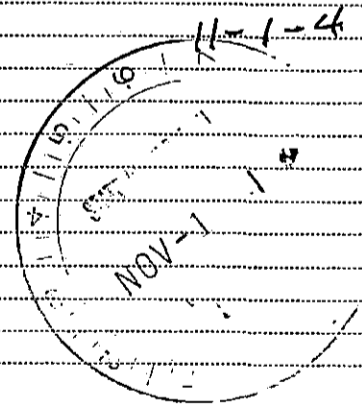

(If additional description is necessary, use BACK of this sheet)

Correspondence regarding this well should be addressed to Hinkle Oil Company
Address 919 Union National Bank Bldg., Wichita, Kansas.

STATE OF Kansas, COUNTY OF Sedgwick, ss.
J. B. Hinkle (employer or owner) of the above-described well,
being first duly sworn on oath, says: That I have knowledge of the facts, statements, and matters herein contained and the log of the above-described well as filed and that the same are true and correct. So help me God.

(Signature) J. B. Hinkle
Wichita, Kansas. (Address)

SUBSCRIBED AND SWORN to before me this 31st day of October, 1941

My commission expires Jan. 17, 1942.

Notary Public.

108' of 10" casing.
 Commenced. 10-14-41
 Completed 10-30-41

Depiesse No. 1. 15.009.06358.00.00
 SW $\frac{1}{4}$ 5-16-12W, Barton County, Kansas.
 Hinkle Oil Company, et. al.
 Contractor Hinkle Oil Company.

Surface	108
Shale	363
Shale, shells & sand	520
Red rock & Shells	660
Shale	785
Lime	820
Shale and shells	924
Shale and lime	1125
Shale	1210
Salt	1430
Shale	1444
Shale & lime shells	1535
Lime	1550
Shale and lime	1583
Lime	1716
Lime and shale breaks	1800
Lime and shale	1882
Lime	2075
Shale	2085
Lime	2106
Broken lime and shale	2197
Lime	2259
Broken lime and shale	2335
Shale	2412
Lime	2450
Shale and lime	2528
Broken lime and shale	2609
Shale	2665
Lime	3326
Conglomerate	3333
Lime Arbuckle	3345
Conglomerate	3382
Quartzite and Sand	3393

Top of Topeka	2694	=	- 822
Top of K. C. Lansing	3047	=	-1174
Top of Conglomerate	3316		
Top of Arbuckle		=	-1461

State of Kansas)
 County of Sedgwick) ss

I hereby certify that the above is a true and correct log of the above described log as compiled from the daily drilling reports kept at said well.

J. B. Hinkle

Subscribed and sworn to this 31st. day of October, 1941.

Muriel A. Upton
 Notary Public.

My commission expires 1-17-42

