


RECEIVED
STATE CORPORATION COMMISSION
MAR 22 1972
CONSERVATION DIVISION
Wichita, Kansas

15.009.30199.00.01

STATE OF KANSAS
STATE CORPORATION COMMISSION

Give All Information Completely
Make Required Affidavit
Mail or Deliver Report to:
Conservation Division
State Corporation Commission
P. O. Box 17027
Wichita, Kansas 67217
NORTH

WELL PLUGGING RECORD

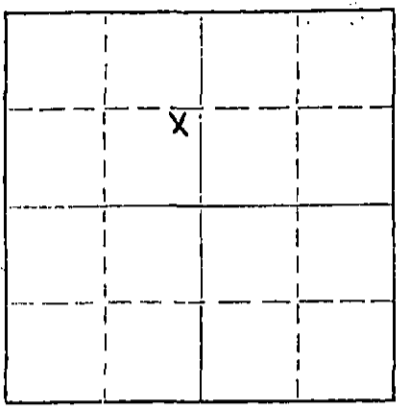

Barton County, Sec. 15 Twp. 20 Rge. 14 (E) W (W)
Location as "NE/CNW/SE/SW" or footage from lines NE SE NW
Lease Owner Messman - Rinehart Oil Co.
Lease Name Ira Unruh Well No. # 1
Office Address 1432 Wichita Plaza, Wichita, Ks. 67202
Character of Well (completed as Oil, Gas or Dry Hole) _____
Date well completed _____ 19____
Application for plugging filed January 19 72
Application for plugging approved January 19 72
Plugging commenced February 26 19 72
Plugging completed February 29 19 72
Reason for abandonment of well or producing formation _____

If a producing well is abandoned, date of last production _____ 19____
Was permission obtained from the Conservation Division or its agents before plugging was commenced? Yes

Name of Conservation Agent who supervised plugging of this well Don Truan
Producing formation _____ Depth to top _____ Bottom _____ Total Depth of Well _____ Feet
Show depth and thickness of all water, oil and gas formations.

OIL, GAS OR WATER RECORDS

CASING RECORD

FORMATION	CONTENT	FROM	TO	SIZE	PUT IN	PULLED OUT
				8 5/8"	822	None
				4 1/2"	3579	2630

Describe in detail the manner in which the well was plugged, indicating where the mud fluid was placed and the method or methods used in introducing it into the hole. If cement or other plugs were used, state the character of same and depth placed, from _____ feet to _____ feet for each plug set.

February 26, 1972 Plugged off bottom. Dumped sand to 3450'. Mixed and dumped 4 sx of cement.

February 29, 1972 Plugged off top. Set 20' rock bridge from 350' to 370'. Filled 8 5/8" surface casing from 350' to base of cellar with 3000 lb. P.S.I. ready-mix concrete.

(If additional description is necessary, use BACK of this sheet)
Name of Plugging Contractor RUSS CASING PULLING, INC.
Address P. O. Box 1082 ; Great Bend, Kansas 67530

STATE OF KANSAS COUNTY OF SEDGWICK, ss.
L. J. A. Gilliland (employee of owner) or (~~owner~~) of the above-described

well, being first duly sworn on oath, says: That I have knowledge of the facts, statements, and matters herein contained and the log of the above-described well as filed and that the same are true and correct. So help me God.

(Signature) [Signature]
1432 Wichita Plaza, Wichita, Kansas 67202
(Address)

Sworn and signed to before me this 3rd day of March, 19 72

August 26, 1973
Arlene L. Sloop Notary Public.



From the desk of - - -

C. B. RINEHART

March 21, 1972

State Corporation Commission


Re: Ira Unruh OWWO
Barton County, Kansas

Gentlemen:

This was a OWWO and no new hole was made and therefore the previous Well Log filed is to apply.

Very truly yours,

MESSMAN-RINEHART OIL COMPANY

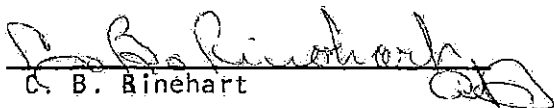
C. B. Rinehart

CBR:als

RECEIVED
STATE CORPORATION COMMISSION
MAR 22 1972
CONSERVATION DIVISION
Wichita, Kansas