

15.009.30199.00.00


WELL PLUGGING RECORD

Give All Information Completely
Make Required Affidavit
Mail or Deliver Report to:
Conservation Division
State Corporation Commission
211 No. Broadway
Wichita, Kansas

Barton County. Sec. 15 Twp. 20S Rge. (E) 14 (W)

Location as "NE/CNW/SW" or footage from lines NE SE NW
Lease Owner John C. Graves & McClure Oil Co.
Lease Name Unruh Well No. 1
Office Address 412 Union Center, Wichita, Kansas
Character of Well (completed as Oil, Gas or Dry Hole) Dry Hole
Date well completed July 21, 1965
Application for plugging filed July 21, 1965
Application for plugging approved July 21, 1965
Plugging commenced July 21, 1965
Plugging completed July 21, 1965
Reason for abandonment of well or producing formation _____

NORTH

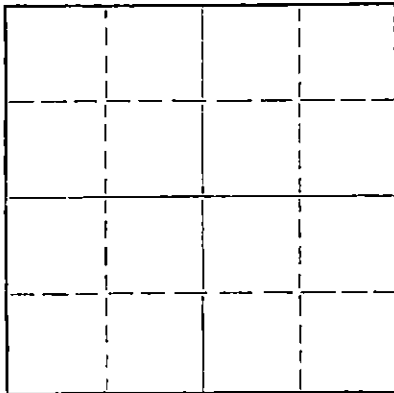

Locate well correctly on above
Section Plat

If a producing well is abandoned, date of last production _____ 19____
Was permission obtained from the Conservation Division or its agents before plugging was commenced? Yes

Name of Conservation Agent who supervised plugging of this well Donald Truan, 634 Sunset, Russell, Kansas
Producing formation _____ Depth to top _____ Bottom _____ Total Depth of Well 3577 Feet
Show depth and thickness of all water, oil and gas formations.

OIL, GAS OR WATER RECORDS

CASING RECORD

FORMATION	CONTENT	FROM	TO	SIZE	PUT IN	PULLED OUT

Describe in detail the manner in which the well was plugged, indicating where the mud fluid was placed and the method or methods used in introducing it into the hole. If cement or other plugs were used, state the character of same and depth placed, from _____ feet to _____ feet for each plug set.
Mudded up with heavy mud to 350 feet. Followed by wooden plug and 1/4 sack hulls. Placed 20 sacks cement onto hulls. Mudded up with heavy mud to 40 feet followed by wooden plug, 1/4 sack hulls and 12 sacks cement to base of well cellar. Plugged rat hole with 3 sacks cement.

RECEIVED
STATE CORPORATION COMMISSION

JUL 29 1965

CONSERVATION DIVISION
Wichita, Kansas

7-29-65

(If additional description is necessary, use BACK of this sheet)
Name of Plugging Contractor Graves Drilling Co., Inc.
Address 412 Union Center, Wichita, Kansas

STATE OF KANSAS, COUNTY OF BUTLER, ss.
John C. Graves (employee of owner) or (owner or operator) of the above-described

well, being first duly sworn on oath, says: That I have knowledge of the facts, statements, and matters herein contained and the log of the above-described well as filed and that the same are true and correct. So help me God.

(Signature) John C. Graves
412 Union Center, Wichita, Kansas
(Address)

SUBSCRIBED AND SWORN TO before me this 28th day of July, 19 65

My commission expires April 30, 1967 Betty Brandt Notary Public.

ROTARY DRILLERS' LOG

OPERATOR: John C. Graves and McClure Oil Co.
412 Union Center
Wichita, Kansas

DRILLING COMMENCED: July 12, 1965

CONTRACTOR: Graves Drilling Co., Inc.
412 Union Center
Wichita, Kansas

DRILLING COMPLETED: July 21, 1965

CASING RECORD: 20 Jts. 822' 8-5/8"
cemented with 475 sacks

LOCATION: Unruh No. 1
NE SB NW
Section 15-20S-14W
Barton County, Kansas

0 - 223 Sand & shale
223 - 255 Shale
255 - 330 Sand
330 - 813 Shale & red bed
813 - 820 Anhydrite
820 - 837 Lime
837 - 1450 Shale
1450 - 1595 Shale & shells
1595 - 2380 Lime & shale
2380 - 2840 Shale & lime
2840 - 3063 Lime & shale
3063 - 3183 Lime
3183 - 3251 Shale
3251 - 3481 Lime
3481 - 3547 Lime & shale
3547 - 3577 Lime
3577 Rotary Total Depth

RECEIVED
STATE CORPORATION COMMISSION
JUL 29 1965
CONSERVATION DIVISION
Wichita, Kansas

I hereby certify the foregoing statements to be true and correct to the best of my knowledge.

GRAVES DRILLING CO., INC.

By John C. Graves President

STATE OF KANSAS)
) SS:
BUTLER COUNTY)

Subscribed and sworn to before me, a Notary Public, this 28th day of July, 1965.

My commission expires:
April 30, 1967

Betty Brandt
Betty Brandt Notary Public