


STATE OF KANSAS
STATE CORPORATION COMMISSION

Give All Information Completely
Make Required Affidavit
Mail or Deliver Report to:
Conservation Division
State Corporation Commission
211 No. Broadway
Wichita, Kansas

15.009.00252.00x00
WELL PLUGGING RECORD

NORTH R 14W

T
17
S

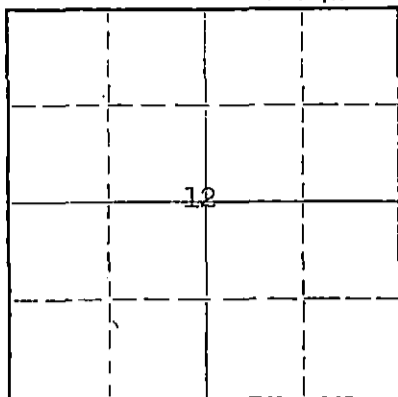

Locate well correctly on above Section Plat

Barton County. Sec. 12 Twp. 17S Rge. (E) 14 (W)
Location as "NE/CNW/SW" or footage from lines SW NE SW
Lease Owner National Associated Petroleum Company
Lease Name PELZ Well No. #1-A
Office Address 502 Ritz Building
Character of Well (completed as Oil, Gas or Dry Hole) Dry hole
Date well completed August 15, 19 59
Application for plugging filed August 15, via phone to Mr. Toman 19 59
Application for plugging approved August 15, via phone to Mr. Toman 19 59
Plugging commenced August 15, 19 59
Plugging completed August 15, 19 59
Reason for abandonment of well or producing formation Dry hole no commercial tests

If a producing well is abandoned, date of last production - 19
Was permission obtained from the Conservation Division or its agents before plugging was commenced? yes (on August 15, 1959 via phone by Joe E. McGarrah)

Name of Conservation Agent who supervised plugging of this well Gilbert Toman
Producing formation - Depth to top - Bottom - Total Depth of Well 3512 Feet
Show depth and thickness of all water, oil and gas formations.

OIL, GAS OR WATER RECORDS

CASING RECORD

FORMATION	CONTENT	FROM	TO	SIZE	PUT IN	PULLED OUT
				8-5/8"	267'	none

Describe in detail the manner in which the well was plugged, indicating where the mud fluid was placed and the method or methods used in introducing it into the hole. If cement or other plugs were used, state the character of same and depth placed, from _____ feet to _____ feet for each plug set.
Hole filled with heavy mud from 3520 to 350, set plug as advised, cemented w/25 sacks on Bottom plug. Hole filled with heavy mud to 40 ft and cemented with 10 sacks on top of top plug.

RECEIVED
STATE CORPORATION COMMISSION
DEC 9 1959
CONSERVATION DIVISION
Wichita, Kansas

(If additional description is necessary, use BACK of this sheet)
Name of Plugging Contractor B. E. Ash
Address Box 206, Ellinwood, Kansas

STATE OF KANSAS, COUNTY OF BARTON, ss.
Joe E. McGarrah (employee of owner) or (owner or operator) of the above-described well, being first duly sworn on oath, says: That I have knowledge of the facts, statements, and matters herein contained and the log of the above-described well as filed and that the same are true and correct. So help me God.

(Signature) Joe E. McGarrah
507 Ritz Bldg Tulsa, Okla (Address)

SUBSCRIBED AND SWORN TO before me this 8th day of December, 19 59

Madeline S. Provenzo Notary Public.

My commission expires February 21, 1961