


WELL PLUGGING RECORD

Give All Information Completely
Make Required Affidavit
Mail or Deliver Report to:
Conservation Division
State Corporation Commission
800 Bittig Building
Wichita, Kansas

NORTH

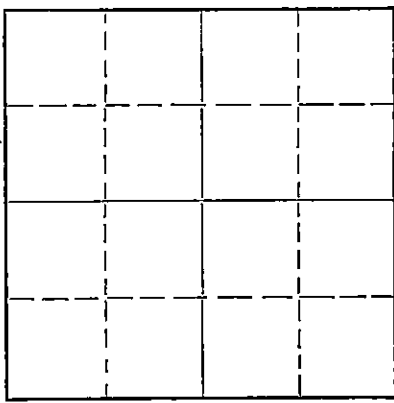

Locate well correctly on above
Section Plat

Barton County. Sec. 10 Twp. 17 Rge. 14 (E) W (W)
Location as "NE/CNW/SW" or footage from lines NE SW SE
Lease Owner Honaker Drlg., Inc. et al
Lease Name Riedl 'B' Well No. 2
Office Address 2008 Lakin, Great Bend, Kansas
Character of Well (completed as Oil, Gas or Dry Hole) Dry Hole
Date well completed October 22 1954
Application for plugging filed _____ 19____
Application for plugging approved October 22 1954
Plugging commenced October 22 1954
Plugging completed October 22 1954
Reason for abandonment of well or producing formation Dry Hole

If a producing well is abandoned, date of last production _____ 19____
Was permission obtained from the Conservation Division or its agents before plugging was commenced? Yes

Name of Conservation Agent who supervised plugging of this well Warren Horner
Producing formation _____ Depth to top _____ Bottom _____ Total Depth of Well _____ Feet
Show depth and thickness of all water, oil and gas formations.

OIL, GAS OR WATER RECORDS

CASING RECORD

FORMATION	CONTENT	FROM	TO	SIZE	PUT IN	PULLED OUT
				8-5/8"	596'	None

Describe in detail the manner in which the well was plugged, indicating where the mud fluid was placed and the method or methods used in introducing it into the hole. If cement or other plugs were used, state the character of same and depth placed, from _____ feet to _____ feet for each plug set.

Pumped hole full of heavy rotary mud from 3484' to 275'. Dumped in 1/3 sack hulls. Set plug. Dumped in 20 sacks cement on top of plug through drill pipe. Filled up to 35' with heavy rotary mud. Dumped in 1/3 sack hulls. Set plug. Dumped 10 sacks cement on top of plug through drill pipe to bottom of cellar.

(If additional description is necessary, use BACK of this sheet)

Name of Plugging Contractor Honaker Drlg., Inc.
Address 2008 Lakin, Great Bend, Kansas


STATE OF Kansas, COUNTY OF Barton, ss.
S. C. Lingreen (employee of owner) or (owner or operator) of the above-described well, being first duly sworn on oath, says: That I have knowledge of the facts, statements, and matters herein contained and the log of the above-described well as filed and that the same are true and correct. So help me God.

(Signature) S. C. Lingreen

SUBSCRIBED AND SWORN to before me this 22nd day of October, 1954

(Address) _____
Samuel D. Fisher
Notary Public.

My commission expires 6-25-55

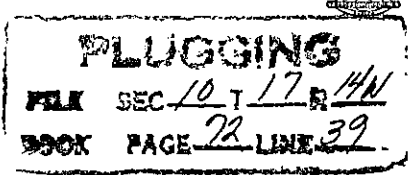

10-29-54

15.009.007/9.00.00

HONAKER DRILG., INC.
2008 Lakin
Great Bend, Kansas

DRILLERS LOG

Riedl 'B' No. 2
Loc: NE SW SE
Sec: 10-17-14w
Barton County, Kansas
Contractor: Honaker Drilg., Inc.

Comm: 10-11-54
Comp: 10-22-54
Total Depth: 3485'
Elevation: 1976' D.F.
1978' R.B.
Casing: 8-5/8" @ 594'

0	515	Post Rock & Shale.	
515	594	Sand & Red Bed.	8-5/8" casing cemented
594	955	Red Bed.	@ 594' w/ 350 sacks
955	985	Anhydrite.	cement and 7 sacks
985	1040	Shale.	calcium chloride.
1040	1670	Shale & Shells.	
1670	1685	Lime.	
1685	3070	Lime & Shale.	
3070	3135	Lime.	
3135	3190	Lime.	
3190	3234	Lime & Shale.	
3234	3485	Lime	
3485		Total Rotary Depth.	Dry and Abandoned.

1974
8-27
10-23

I certify that this is the true and correct copy of the above log, to the best of my knowledge.

A. Fisher

Subscribed and sworn to before me this 28th day of October, 1954.

Ernest D. Fisher
Notary Public

My Commission Expires: 6-25-55

PLUGGING
FILE SEC 10 T 17 R 14W
BOOK PAGE 22 LINE 29