


WELL PLUGGING RECORD

Give All Information Completely  
Make Required Affidavit  
Mail or Deliver Report to:  
Conservation Division  
State Corporation Commission  
800 Bittling Building  
Wichita, Kansas

Barton County, Sec. 24 Twp. 17 Rge. 13 (E) (W)

Location as "NE/CNW $\frac{1}{4}$ SW $\frac{1}{4}$ " or footage from lines NW NW NE  
Lease Owner Cooperative Refinery Association  
Lease Name Czermack Well No. 1  
Office Address Box 765, Great Bend, Kansas  
Character of Well (completed as Oil, Gas or Dry Hole) Dry Hole  
Date well completed April 2, 1951 19  
Application for plugging filed April 13, 1951 19  
Application for plugging approved April 1, 1951 19  
Plugging commenced April 3, 1951 19  
Plugging completed April 3, 1951 19  
Reason for abandonment of well or producing formation Dry Hole

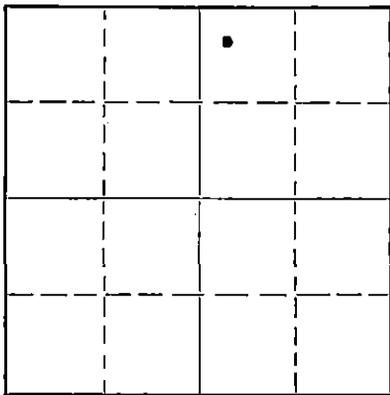

Locate well correctly on above Section Plat

If a producing well is abandoned, date of last production -0- 19  
Was permission obtained from the Conservation Division or its agents before plugging was commenced? Yes

Name of Conservation Agent who supervised plugging of this well Stough  
Producing formation Depth to top Bottom Total Depth of Well 3386 Feet  
Show depth and thickness of all water, oil and gas formations.

OIL, GAS OR WATER RECORDS

CASING RECORD

Formation	Content	From	To	Size	Put In	Pulled Out
				8-5/8"	251	None

Describe in detail the manner in which the well was plugged, indicating where the mud fluid was placed and the method or methods used in introducing it into the hole. If cement or other plugs were used, state the character of same and depth placed, from feet to feet for each plug set.

Fill hole to 251, set plug and cemented through D.P. with 15 sacks cement.  
Fill hole from 250 to 30' from top. Set plug and cemented to top with 10 sacks cement.

RECEIVED  
STATE CORPORATION COMMISSION

APR 18 1951

4-18-51

CONSERVATION DIVISION  
Wichita, Kansas

(If additional description is necessary, use BACK of this sheet)

Correspondence regarding this well should be addressed to Cooperative Refinery Association  
Address Box 765, Great Bend, Kansas

STATE OF KANSAS, COUNTY OF BARTON, ss.  
L. M. Collins (employee of owner) or (owner or operator) of the above-described well,  
being first duly sworn on oath, says: That I have knowledge of the facts, statements, and matters herein contained and the log of the above-described well as filed and that the same are true and correct. So help me God.

(Signature) L M Collins  
Box 765, Great Bend, Kansas  
(Address)

SUBSCRIBED AND SWORN to before me this 2nd day of April 2, 1951

Arthur J. Johnson  
Notary Public.

My commission expires Feb. 14, 1955

PLUGGING  
FILE SEC 24 T 17 R 13  
BOOK PAGE 76 LINE 17

15.009.00601.00.00

COMPANY: CRA and NAPC SEC: 24 T. 17S R. 13W  
 FARM: Czermack "A" No. 1 LOCATION: NW NW NE  
 COMM: 3-22-51 COMP: 4-2-51 COUNTY: Barton  
 CONTRACTOR: CRA tools. STATE: Kansas  
 CASING: 8-5/8" @ 251' w/150 ELEVATION: 1840 D.F.  
 TOTAL DEPTH: 3386 PRODUCTION: D & A

Figures Indicate Bottoms of Formations

shale 40  
 shale and shells 255  
 sand 285  
 lime and pyrite 365  
 shale and shells 755  
 anhydrite 770  
 shale and shells 1587  
 lime 2030  
 shale and shells 2685  
 shale and lime 2935  
 lime 3198  
 lime and shale 3260  
 lime 3390

GEOLOGICAL TOPS D.F.

Heebner 3002  
 Toronto 3020  
 Brown Lime 3093  
 Lansing-K.C. 3112  
 Basal Penn. Conglomerate 3344  
 Arbuckle 3357

Ran Schlumberger

RTD 3390 = 3386 D.F.

**RECEIVED**  
 STATE CORPORATION COMMISSION  
 JUL 21 1951  
 CONSERVATION DIVISION  
 Wichita, Kansas

**PLUGGING**  
 FILE SEC. 24 T. 17 R. 13W  
 BOOK PAGE 74 LINE 17

