


WELL PLUGGING RECORD

Give All Information Completely
Make Required Affidavit
Mail or Deliver Report to:
Conservation Division
State Corporation Commission
800 Bittling Building
Wichita, Kansas

NORTH

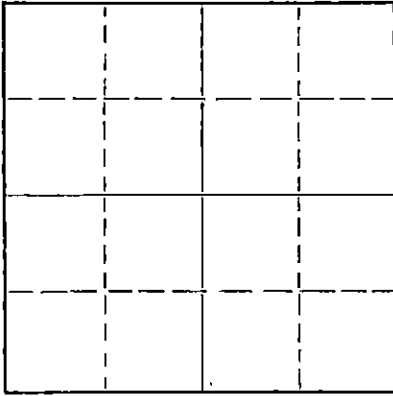

Locate well correctly on above Section Plat

McPherson County. Sec. 18 Twp. 21 Rge. 5 (E) W (W)
Location as "NE/CNWxSWx" or footage from lines SE SW SE
Lease Owner Stag Drilling Inc., et al
Lease Name Neufeld Well No. _____
Office Address Box 169 Chase, Kansas
Character of Well (completed as Oil, Gas or Dry Hole) Dry hole
Date well completed 10/17/54 19
Application for plugging filed 10/17/54 19
Application for plugging approved 10/17/54 19
Plugging commenced 10/17/54 19
Plugging completed 10/17/54 19
Reason for abandonment of well or producing formation _____

If a producing well is abandoned, date of last production _____ 19
Was permission obtained from the Conservation Division or its agents before plugging was commenced? yes

Name of Conservation Agent who supervised plugging of this well Ruell Durkee
Producing formation _____ Depth to top _____ Bottom _____ Total Depth of Well 4034 Feet
Show depth and thickness of all water, oil and gas formations.

OIL, GAS OR WATER RECORDS

CASING RECORD

FORMATION	CONTENT	FROM	TO	SIZE	PUT IN	PULLED OUT
		0	155	8 5/8"		

Describe in detail the manner in which the well was plugged, indicating where the mud fluid was placed and the method or methods used in introducing it into the hole. If cement or other plugs were used, state the character of same and depth placed, from 155 feet to 30 feet for each plug set.

Used two Halliburton plugs, push first plug to the depth of 155 feet, cemented 15 sacks cement, cemented through drill pipe, push plug #2 to depth 30 feet, cemented with 10 sacks cement

5 sacks cement in rat hole.

*Filed
10-17-54*

(If additional description is necessary, use BACK of this sheet)

Name of Plugging Contractor Stag Drilling Inc.,
Address Box 169 Chase, Kansas

STATE OF Kansas, COUNTY OF Rice, ss.

_____(employee of owner) or (owner or operator) of the above-described well, being first duly sworn on oath, says: That I have knowledge of the facts, statements, and matters herein contained and the log of the above-described well as filed and that the same are true and correct. So help me God.

(Signature) *G. L. Durkee*


(Address) _____

SUBSCRIBED AND SWORN TO before me this 22 day of October, 1954

Orlando Miller

Notary Public.

My commission expires 3-1-55

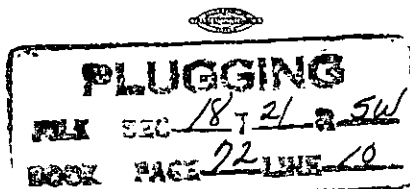

CONTRACTOR'S WELL LOG

OPERATOR D.B. Mitchell et al FARM NAME Neufeld WELL NO. 1
 LOCATION CS₂ S₂ SE COUNTY McPherson STATE Kansas
 COMMENCEMENT DATE 10/1/54 COMPLETION DATE 10/17/54

LOG OF WELL

FROM	TO	FORMATION	DEVIATION FROM VERTICAL	REMARKS
0	155	Surface hole		
155	300	Shale Shells		
300	425	Salt	$\frac{10}{2}$ -300'	
425	920	Lime shale		
920	1056	Lime shale sandy		
1056	1126	Lime shale		
1126	1225	Sandy lime shale		
1225	1625	Lime shale		
1625	1910	shale shells		
1910	2045	lime shale		
2045	2160	shale shells		
2160	2270	lime shale		
2270	2560	lime		
2560	2565	shale		
2565	2625	Lime		
2625	2784	Lime shale		
2784	3255	lime		
3255	3362	lime shale		
3362	3440	cong.		
3440	3580	Miss.		
3580	3601	Chat		
3601	3628	Chat-lime chert		
3628	3750	lime shale		
3750	3823	Shale lime iron		
3823	3855	Sand shale		
3855	3883	Lime chert		
3883	3915	Viola		
3915	3922	Simpson		
3922	3955	Simpson, chert, iron, sand, dolomite		
3955	3982	Simpson		
3982	4034	Arb. Total Depth dry hole		

Set 155' (7 jts) 8 5/8" casing

STATE OF KANSAS)
) SS
 COUNTY OF RICE)

The undersigned certifies that to the best of his knowledge and belief the above facts are true and correct.

STAG DRILLING INC.,
 BY C. S. Durrell
 President

Subscribed and sworn to before me this 22nd day October, 1954

My Commission expires 3/1/55

Orlando Miller
 Notary Public

PLUGGING
 FILE SEC 18 T 21 R 5W
 BOOK PAGE 78 LINE 10