


WELL PLUGGING RECORD

Give All Information Completely
Make Required Affidavit
Mail or Deliver Report to:
Conservation Division
State Corporation Commission
800 Bittling Building
Wichita, Kansas

McPherson County. Sec. 31 Twp. 21 Rge. 4 (E) (W)

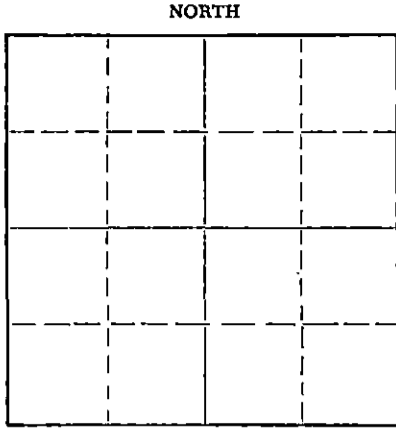

Locate well correctly on above
Section Plat

Location as "NE/CNW%SW%" or footage from lines NE SE NW
Lease Owner Trans Era Petroleum, Inc.
Lease Name Thiessen #1 Well No. 1
Office Address 420 W. Douglas, Wichita, Kansas
Character of Well (completed as Oil, Gas or Dry Hole) Dry Hole
Date well completed 11/24/55 19
Application for plugging filed 11/23/55 19
Application for plugging approved 11/23/55 19
Plugging commenced 11/24/55 19
Plugging completed 11/24/55 19
Reason for abandonment of well or producing formation Dry Hole

If a producing well is abandoned, date of last production 19

Was permission obtained from the Conservation Division or its agents before plugging was commenced? yes

Name of Conservation Agent who supervised plugging of this well Ruel Durkee

Producing formation _____ Depth to top _____ Bottom _____ Total Depth of Well 4015 Feet

Show depth and thickness of all water, oil and gas formations.

OIL, GAS OR WATER RECORDS

CASING RECORD

FORMATION	CONTENT	FROM	TO	SIZE	PUT IN	PULLED OUT
				8 5/8	248	none

Describe in detail the manner in which the well was plugged, indicating where the mud fluid was placed and the method or methods used in introducing it into the hole. If cement or other plugs were used, state the character of same and depth placed, from _____ feet to _____ feet for each plug set.

PLUGGING RECORD

Filled hole with heavy mud from 4015 to 240'. Set first plug, using 1/2 sack hulls and 15 sacks cement through drill pipe. Filled hole with heavy rotary mud from 210' up to 25'. Set 2nd Halliburton plug, using 1/2 sack hulls and 5 sacks cement. Job completed 4 AM

(If additional description is necessary, use BACK of this sheet)

Name of Plugging Contractor Trans Era Petroleum, Inc.
Address 420 West Douglass, Wichita, Kansas

STATE OF KANSAS, COUNTY OF RUSSELL, ss.
C. T. Honaker (employee of owner) or (owner or operator) of the above-described well, being first duly sworn on oath, says: That I have knowledge of the facts, statements, and matters herein contained and the log of the above-described well as filed and that the same are true and correct. So help me God.

(Signature) C. T. Honaker

(Address)

SUBSCRIBED AND SWORN TO before me this 28th day of November, 1955

Margie Cooper Notary Public.

My commission expires 1-30-57

PLUGGING
FILED REC 31 T 21 R 4 W
BOOK PAGE 19 LINE 15

11-29-55

Trans Era Petroleum, Inc.
THEISSEN #1

NE SE NW 31-21-4
McPherson County, Kansas

Total Depth: 4015

Comm: 11/6/55
Comp: 11/24/55

Casing 8 5/8 @ 248'
Cement 248'sacks of Bulk

FORMATION	DEPTH
Surface soil	30
Red Bed - shale	40
Red bed - shale & shells	248
Shale	510
Salt & shale	690
Shale & gyp	785
Lime & shale	2115
Lime	2180
Lime & shale	2364
Lime	2438
Lime & shale	2575
Lime	2718
Lime & shale	2837
Lime	3059
Lime & shale	3373
Lime	3481
Lime & chert	3592
Lime & shale, chert	3620
Lime & shale	3911
Viola	3921
Simpson	3995
Sand	3998
Arbuckle	4015

Tops:

Topeka	2139
Heebner	2466
Douglas	2490
Brown Lime	2655
Lans.	2694
Miss.	3369
Hunt	3373
McQuota	3784
Dolo	3848
Viola	3906
Simp.	3921
Arb.	3998

RECORDED
NOV 27 1955
CONSERVATION DIVISION
Wichita, Kansas

STATE OF KANSAS)
) ss:
COUNTY OF RUSSELL)

I hereby certify that the above information is true and correct to the best of my knowledge.

C. P. Hencken

Subscribed and sworn to before me this 28th day of November, 1955.

Margie Cooper
Notary Public

My commission expires: 1-30-57

PLUGGING
REC-31-21-4W
BOOK PAGE 19-LINE 15