

STATE OF KANSAS  
STATE CORPORATION COMMISSION

WELL PLUGGING RECORD


15-009-21990-0000

Give All Information Completely  
Make Required Affidavit  
Mail or Deliver Report to  
Conservation Division  
State Corporation Comm.  
245 North Water  
Wichita, KS 67202

Barton County, Sec. 13 Twp. 16S Rge. 12 SE/W  
Location as "NE/CNWSW" or footage from lines  
C S/2 N/2 SE/4

Lease Owner Petroleum Energy, Inc.  
Lease Name Hoffman Well No. 1  
Office Address 710 One Twenty Bldg., Wichita, Ks. 67202  
Character of Well (Completed as Oil, Gas or Dry Hole) Dry Hole

Date Well completed 7-10 1980  
Application for plugging filed 7-10 1980  
Application for plugging approved 7-10 1980  
Plugging commenced 7-10 1980  
Plugging completed 7-10 1980  
Reason for abandonment of well or producing formation \_\_\_\_\_

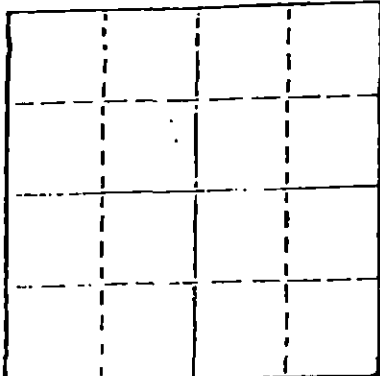

Locate well correctly on above  
Section Plat

If a producing well is abandoned, date of last production  
\_\_\_\_\_ 19\_\_\_\_

Was permission obtained from the Conservation Division or  
its agents before plugging was commenced? Yes

Name of Conservation Agent who supervised plugging of this well Duane L. Rankin  
Producing formation \_\_\_\_\_ Depth to top \_\_\_\_\_ Bottom \_\_\_\_\_ Total Depth of Well 3390'  
Show depth and thickness of all water, oil and gas formations.

OIL, GAS OR WATER RECORDS

CASING RECORD

FORMATION	CONTENT	FROM	TO	SIZE	PUT IN	PULLED OUT
				8 5/8"	280'	None

Describe in detail the manner in which the well was plugged, indicating where the mud fluid  
was placed and the method or methods used in introducing it into the hold. If cement or other  
plugs were used, state the character of same and depth placed, from \_\_\_\_\_ feet to  
\_\_\_\_\_ feet for each plug set,

50 sx cement at 480'  
30 sx cement at 270'  
5 sx cement in rathole.


(If additional description is necessary, use BACK of this sheet) 08-08-80

Name of Plugging Contractor White & Ellis Drilling, Inc.  
401 E. Douglas - Suite 500, Wichita, Kansas 67202

STATE OF KANSAS COUNTY OF SEDGWICK, ss.  
Thomas D. White (employee of owner) or (owner or operator)  
of the above-described well, being first duly sworn on oath, says: That I have knowledge of  
the facts, statements, and matters herein contained and the log of the above-described well  
as filed and that the same are true and correct. So help me God.

(Signature) Thomas D. White  
401 E. Douglas - Suite 500, Wichita, Ks.  
(Address) 67202

SUBSCRIBED AND SWORN TO before me this 23rd day of July, 19 80.

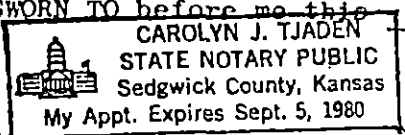

Carolyn J. Tjaden  
Carolyn J. Tjaden Notary Public.

My commission expires \_\_\_\_\_

DRILLERS LOG

OPERATOR: PETROLEUM ENERGY, INC., 710 One Twenty Bldg., Wichita, Ks. 67202

CONTRACTOR: White & Ellis Drilling, Inc., Box 448, El Dorado, Kansas 67042

Lease Name Hoffman Well No. 1

Sec. 13 T. 10S R. 12W Spot C S/2 N/2 SE/4

County Barton State Kansas Elevation \_\_\_\_\_

Casing Record:

Surface: 8 5/8" @ 280' with 165 Sxs. 3% CC  
2% Gel

Production: \_\_\_\_\_ @ \_\_\_\_\_ with \_\_\_\_\_ Sxs.

Type Well: D & A Total Depth 3390'

Drilling Commenced: 7-1-80 Drilling Completed 7-10-80

Formation	From	To	Tops
Cellar	0	7	
Shale & Lime	7	2835	
Lime	2835	3390	

RECEIVED  
STATE CORPORATION COMMISSION  
1980 - 8-1-80  
OIL & GAS DIVISION  
Wichita, Kansas

COMPLETION RECORD

Liner Record: Size \_\_\_\_\_ From \_\_\_\_\_ To \_\_\_\_\_

Cementing Record: \_\_\_\_\_ Sacks \_\_\_\_\_

Perforating Record:

Formation	Perforated Interval	Number Shots
_____	_____	_____
_____	_____	_____
_____	_____	_____
_____	_____	_____

Initial Production: \_\_\_\_\_

Electric Log \_\_\_\_\_ Type and Depths Covered \_\_\_\_\_

\_\_\_\_\_  
\_\_\_\_\_