

WELL PLUGGING RECORD

Give All Information Completely
Make Required Affidavit
Mail or Deliver Report to:
Conservation Division
State Corporation Commission
800 Biting Building
Wichita, Kansas

15-009-15762-0000

Barton County, Sec. 13 Twp. 16S Rge. 12W (E) (W)

Location as "NE/CNW/SW" or footage from lines. C E/2 SW SW

Lease Owner J. E. Day, Agent

Lease Name Dolechek Well No. 10

Office Address Box 429 - Salina, Kansas

Character of Well (completed as Oil, Gas or Dry Hole) Dry Hole

Date well completed 11-13-51 19

Application for plugging filed March 29 1954

Application for plugging approved March 29 1954


Plugging commenced March 30 1954

Plugging completed April 3 1954

Reason for abandonment of well or producing formation Dry Hole

If a producing well is abandoned, date of last production 19

Was permission obtained from the Conservation Division or its agents before plugging was commenced? Yes

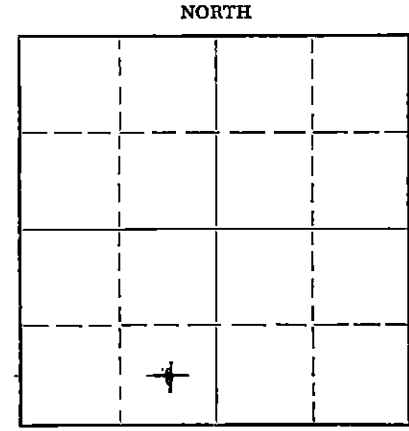

Locate well correctly on above Section Plat

Name of Conservation Agent who supervised plugging of this well Warren Horner

Producing formation Arbuckle Depth to top 3323 Bottom 3336 Total Depth of Well 3336 Feet

Show depth and thickness of all water, oil and gas formations.

OIL, GAS OR WATER RECORDS

CASING RECORD

FORMATION	CONTENT	FROM	TO	SIZE	PUT IN	PULLED OUT
Arbuckle	Water	3323	3324	8-5/8"	500'	None
				5-1/2"	3323'	2641'
Water-Sand	Water	3324	3336			

Describe in detail the manner in which the well was plugged, indicating where the mud fluid was placed and the method or methods used in introducing it into the hole. If cement or other plugs were used, state the character of same and depth placed, from feet to feet for each plug set.

Filled hole with sand from 3336' to 3315' and ran 5 sacks of cement. Mudded hole to 300', set a 10' rock bridge and ran 20 sacks of cement. Mudded hole to top and ran 10 sacks of cement. Plugging completed.

05-25-54

Reason For Not Plugging Well Before-We Thought We Would Complete Same For Disposal-Well-Decided To Plug-Same

Name of Plugging Contractor West Supply Company
Address Chase, Kansas

STATE OF Kansas COUNTY OF Barton, ss.
J. E. Day-Agent (employee of owner) or (owner or operator) of the above-described

well, being first duly sworn on oath, says: That I have knowledge of the facts, statements, and matters herein contained and the log of the above-described well as filed and that the same are true and correct. So help me God.

(Signature) J. E. Day-Agent
Box-429 - Salina Kansas
(Address)

SUBSCRIBED AND SWORN to before me this 22 day of May, 1954

My commission expires Sept 24-1955
Laura Hal... Notary Public.

PLUGGING
WELL REC 13 16 R 12W
BOOK PAGE 23 LINE 33