STATE OF KANSAS
STATE CORPORATION COMMISSION

Give All Information Completely
Make Required Affidavit
Mail or Deliver Report to:
Conservation Division
State Corporation Commission
800 Bitting Building
Wichita, Kansas

# WELL PLUGGING RECORD
OR 15-009-07253-0000
# FORMATION PLUGGING RECORD

Strike out upper line when reporting plugging off formations.

NORTH

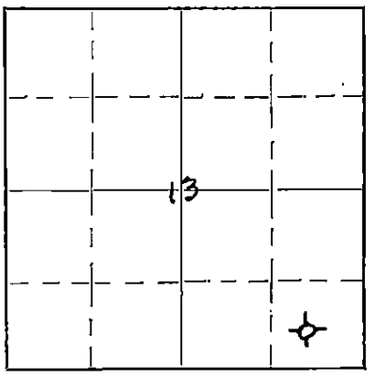


Locate well correctly on above Section Plat

Barton County. Sec. 13 Twp. 16S Rge. (E) 12 (W)
Location as "NE¼NW¼SW¼" or footage from lines 330 ft. N & 440 W of E & S lines
Lease Owner The Bradley Oil Company
Lease Name Anna Holder Well No. 1
Office Address P O Drawer 1400 Wichita, Kansas
Character of Well (completed as Oil, Gas or Dry Hole) dry hole
Date, well completed Aug. 24th, 1940 193
Application for plugging filed ~~Aug. 24th~~ Sept. 19th, 1940 193
Application for plugging approved Aug. 26th, 1940 193
Plugging Commenced Aug. 24th, 1940 193
Plugging Completed Aug. 24th, 1940 193
Reason for abandonment of well or producing formation dry hole

If a producing well is abandoned, date of last production 193
Was permission obtained from the Conservation Division or its agents before plugging was commenced? yes.
Name of Conservation Agent who supervised plugging of this well C.T. Alexander
Producing formation none Depth to top Bottom Total Depth of Well 3345 Feet
Show depth and thickness of all water, oil and gas formations.

OIL, GAS OR WATER RECORDS — CASING RECORD

| Formation | Content | From | To | Size | Put In | Pulled Out |
|---|---|---|---|---|---|---|
| | | | | 10¾ | 410 | none |

Describe in detail the manner in which the well was plugged, indicating where the mud fluid was placed and the method or methods used in introducing it into the hole. If cement or other plugs were used, state the character of same and depth placed, from feet to feet for each plug set.

Mudded to bottom of surface casing and put in cement plug of 10 sax cement, then mud to within 10 ft of top and placed plug of 5 sax cement and then welded top of surface casing

| Well Log: | t.d. | | t.d. |
|---|---|---|---|
| rock and shells | 43 | lime and shale | 3122 |
| shale and shells | 708 | conglomerate & lime | 3345 |
| anhydrite | 736 | | |
| red bed, shale & shells | 790 | | |
| shale and shells | 1121 | | |
| salt | 1198 | | |
| shale and salt | 1360 | | |
| shale and shells | 1640 | | |
| lime and shale | 1815 | | |
| lime broken | 1890 | | |
| lime and shale | 2036 | | |
| shale and shells | 2633 | | |
| lime broken | 2651 | | |
| lime and shale | 2783 | | |
| lime | 2826 | | |

13 16 12W
113 45

RECEIVED SEP 20 1940 STATE CORP. COMM. CONSERV. DIV.

09-20-40

(If additional description is necessary, use BACK of this sheet)

Correspondence regarding this well should be addressed to The Bradley Oil Co.
Address P. O. Drawer 1400, Wichita, Kansas.

STATE OF Kansas, COUNTY OF Sedgwick, ss.
Claude J. Dillon (employee of owner) or (owner or operator) of the above-described well, being first duly sworn on oath, says: That I have knowledge of the facts, statements, and matters herein contained and the log of the above-described well as filed and that the same are true and correct. So help me God.

(Signature) Claude J. Dillon

P.O. Drawer 1400 Wichita, Kansas.
(Address)

SUBSCRIBED AND SWORN TO before me this 19th day of Sept., 19 40.

Bessie M. John
Notary Public.

My commission expires July 30th, 1942.

18-357 7-39—3M