

WELL PLUGGING RECORD


15-009-07251-0980

Information Completely
Required Affidavit
Must be Delivered Report to:
Conservation Division
State Corporation Commission
211 No. Broadway
Wichita, Kansas

Barton County, Sec. 13 Twp. 16 Rge. 12 (E) W (W)

Location as "NE/CNW/SW" or footage from lines SE NE NW
Lease Owner Morgenstern & Specter, Inc.
Lease Name F. N. Weber Well No. 3
Office Address Russell, Kansas
Character of Well (completed as Oil, Gas or Dry Hole) oil
Date well completed 3-31-47 19
Application for plugging filed 7-7-65 19
Application for plugging approved 7-8-65 19
Plugging commenced 7-13-65 19
Plugging completed 7-17-65 19
Reason for abandonment of well or producing formation Depleted.

NORTH

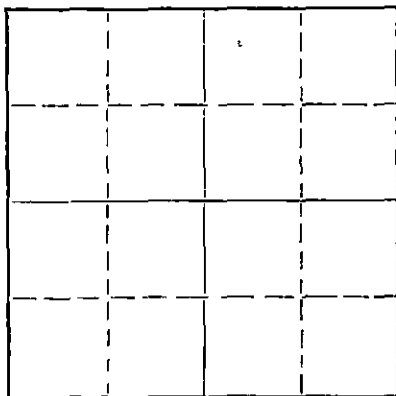

Locate well correctly on above
Section Plat

If a producing well is abandoned, date of last production 19
Was permission obtained from the Conservation Division or its agents before plugging was commenced? yes

Name of Conservation Agent who supervised plugging of this well Don Truan
Producing formation arbuckle Depth to top 3347' Bottom 3311' Total Depth of Well 3312 Feet
Show depth and thickness of all water, oil and gas formations.

OIL, GAS OR WATER RECORDS

CASING RECORD

FORMATION	CONTENT	FROM	TO	SIZE	PUT IN	PULLED OUT
				8-5/8"	240'	None
				5-1/2"	3310'	1484'

Describe in detail the manner in which the well was plugged, indicating where the mud fluid was placed and the method or methods used in introducing it into the hole. If cement or other plugs were used, state the character of same and depth placed, from _____ feet to _____ feet for each plug set.

Checked hole to 3310', pushed plug to 2900', unsanded to 2840' and dumped 5 sacks of cement @ 2840' with dump bailer. Pulled 5 1/2" casing, checked hole to mud bridge @ 240', set rock bridge to 230' and dumped 25 sacks of cement @ 230'. Mudded hole to 40', set rock bridge to 30' and ran 10 sacks of cement to base of cellar.

RECEIVED
STATE CORPORATION COMMISSION

JUL 28 1965 07-28-65

PLUGGING COMPLETE

CONSERVATION DIVISION
Wichita, Kansas

Name of Plugging Contractor KNIGHT CASING PULLING COMPANY
Address CHASE, KANSAS

STATE OF KANSAS, COUNTY OF RICE, ss.
Noel J. Knight (employee of owner) or (owner/operator) of the above-described well, being first duly sworn on oath, says: That I have knowledge of the facts, statements, and matters herein contained and the log of the above-described well as filed and that the same are true and correct. So help me God.

(Signature) Noel J. Knight
Chase, Kansas

SUBSCRIBED AND SWORN TO before me this 20th day of July, 19 65

My commission expires May 20, 1968 Milton J. Volin Notary Public.

WELL LOG BUREAU — KANSAS GEOLOGICAL SOCIETY
Wichita, Kansas


Copy

Company - BLACK-MARSHALL OIL CO.
Farm - F & N Webber No. 3

SEC. 13 T. 16 R. 12W
SE NE NW

Total Depth. 3313
Comm. 3-21-47 Comp. 3-31-47
Shot or Treated.
Contractor. Black-Marshall
Issued. 12-3-49

County. Barton
KANSAS

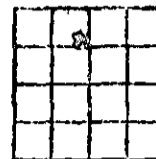

CASING:
8" set @ 240' w/100 ex.
5" set @ 3311' w/125 ex.

Elevation. _____

Production. 302 Bbls.

Figures indicate Bottom of Formations.

Post rock	41
Shale & shells	195
Sand	220
Shale & lime	240
Shale & shells	410
Shale, shells red bed	715
Anhydrite	745
Shale, shells red bed	1150
Salt	1400
Shale & lime	1885
Lime	1935
Shale & shells	1995
Shale & lime	2305
Shale & shells	2465
Shale & lime	2780
Lime	2825
Broken lime	2905
Lime & shale	3060
Lime	3160
Broken lime	3300
Lime	3311
Lime	3313

Total Depth

FORMATION TOPS:

Anhydrite	715
Kansas City	3048
Arbuckle	3310

RECEIVED
STATE CORPORATION COMMISSION

JUL 8 1935

CONSERVATION DIVISION
Wichita, Kansas