


WELL PLUGGING RECORD

OR 15-009-06532-0990  
FORMATION PLUGGING RECORD Strike out upper line when reporting plugging of formations.

Give All Information Completely  
Make Required Affidavit  
Mail or Deliver Report to:  
Conservation Division  
State Corporation Commission  
800 Bitting Building  
Wichita, Kansas

NORTH

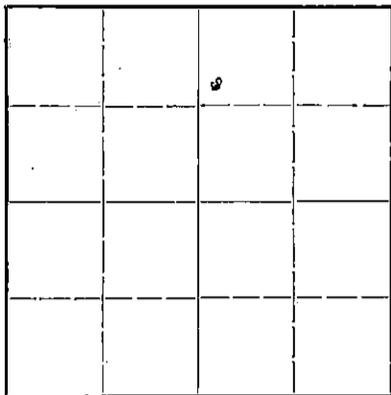

Locate well correctly on above Section Plat

Barton County, Sec. 13 Twp. 16 Rge. 12 (E) (W)  
Location as "NE $\frac{1}{4}$ NW $\frac{1}{4}$ SW $\frac{1}{4}$ " or footage from lines SW NW SE  
Lease Owner Black-Marshall Oil Co  
Lease Name A. Hoffman Well No. 7  
Office Address Box 6, Great Bend, Kansas.  
Character of Well (completed as Oil, Gas or Dry Hole) dry-hole  
Date well completed 1-9-1947  
Application for plugging filed 1-9-1947  
Application for plugging approved 1-13-1947  
Plugging commenced 1-9-1947  
Plugging completed 1-9-1947  
Reason for abandonment of well or producing formation dry-hole

If a producing well is abandoned, date of last production 19  
Was permission obtained from the Conservation Division or its agents before plugging was commenced? yes

Name of Conservation Agent who supervised plugging of this well H.W. Kerr  
Producing formation Depth to top Bottom Total Depth of Well 3341' Feet  
Show depth and thickness of all water, oil and gas formations.

OIL, GAS OR WATER RECORDS

CASING RECORD

Formation	Content	From	To	Size	Put In	Pulled Out
Rotary Hole				8 5/8"	240'	none
				Elec. Weld. bulk	cemented	w/90 sks
					cement	returned.

Describe in detail the manner in which the well was plugged, indicating where the mud fluid was placed and the method or methods used in introducing it into the hole. If cement or other plugs were used, state the character of same and depth placed, from feet to feet for each plug set.

Filled hole with heavy mud to 240'-set wood plug @ 240'-run 15 sacks cement-filled hole with heavy mud to 35'-set wood plug-run 10 sacks cement up into cellar.

FILE 13-16120  
DIS. PAGE 92-4

(If additional description is necessary, use BACK of this sheet)

Correspondence regarding this well should be addressed to Black-Marshall Oil Co  
Address Box 6, Great Bend, Kansas.

STATE OF Kansas, COUNTY OF Barton, ss.  
Walter C. Roberts (employee of owner) or (owner or operator) of the above-described well, being first duly sworn on oath, says: That I have knowledge of the facts, statements, and matters herein contained and the log of the above-described well as filed and that the same are true and correct. So help me God.

(Signature) Walter C Roberts  
Claflin, Kansas.  
(Address)

SUBSCRIBED AND SWORN to before me this 15 day of January 1947  
Edwin Wojdysh  
Notary Public.

My commission expires Feb. 15 1947

01-24-47

JAN 17 1947

COMPANY: Black-Marshall Oil Company  
 CONTRACTOR: Black-Marshall Oil Company  
 COMMENCED: 12-31-46  
 COMPLETED: 1-9-47

FARM: A. Hoffman #7  
 LOCATION: SW NW SE 13-16-12  
 Barton Co., Kansas

ELEVATION: 1874'  
 PRODUCTION: D. & A.

CASING RECORD:

8 5/8" @ 241' - 90 sks.

<u>Formation</u>	<u>Depth</u>		<u>Tops</u>
Clay and post rock	40		
Sand and shells	241		
Shale and shells	285		
Shale and lime	730		
Anhydrite	755		
Redbed and shale	1170	Anhydrite	- 730'
Salt	1440	K. C.	- 3045'
Shale and shells	1515	Conglomerate	- 3305'
Shale and lime	2105		
Shale, lime, and shells	2305		
Shale and shells	2615		
Shale and lime	3153		
Lime	3225		
Shale and lime	3340		
Conglomerate	3341		
ROTARY TOTAL DEPTH	3341		

STATE OF KANSAS )  
 ) SS  
 COUNTY OF BARTON )

We hereby certify this to be a correct and accurate log of the above described well as shown by the daily drilling reports.

BLACK-MARSHALL OIL COMPANY

13 16 12W  
 92 4

*Lawrence A. Huff*  
 Vice-President

Subscribed and sworn to before me this 16th day of January, 1947.

*Carmen Reinhardt Seifer*  
 Notary Public

My commission expires February 19, 1949.

1947  
 JAN 21 1947