


WELL PLUGGING RECORD

Give All Information Completely
Make Required Affidavit
Mail or Deliver Report to:
Conservation Division
State Corporation Commission
211 No. Broadway
Wichita, Kansas

Barton County. Sec. 13 Twp. 16S Rge. 12W (E) (W)
Location as "NE/CNW/SW" or footage from lines SW SW SW
Lease Owner J. E. Day, Agent
Lease Name Dolechek Well No. 6
Office Address Box 7 Eldorado, Kansas
Character of Well (completed as Oil, Gas or Dry Hole) Oil Well
Date well completed May 19 47
Application for plugging filed December 29, 19 55
Application for plugging approved December 30, 19 55
Plugging commenced January 3 19 56
Plugging completed January 6 19 56
Reason for abandonment of well or producing formation Depleted.

T 16S NORTH R 12W

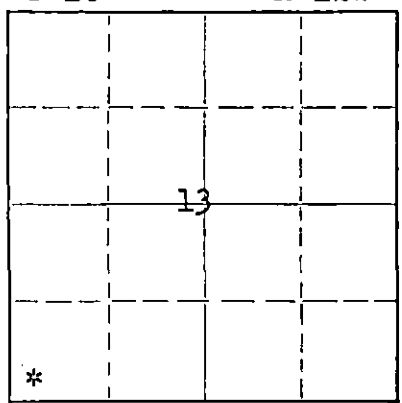

Locate well correctly on above Section Plat

If a producing well is abandoned, date of last production December 19 55
Was permission obtained from the Conservation Division or its agents before plugging was commenced? Yes

Name of Conservation Agent who supervised plugging of this well Brundege
Producing formation _____ Depth to top _____ Bottom _____ Total Depth of Well 3242 Feet
Show depth and thickness of all water, oil and gas formations.

OIL, GAS OR WATER RECORDS

CASING RECORD

FORMATION	CONTENT	FROM	TO	SIZE	PUT IN	PULLED OUT
				12 1/2"	355'	None
				5 1/2"	3227'	2699'

Describe in detail the manner in which the well was plugged, indicating where the mud fluid was placed and the method or methods used in introducing it into the hole. If cement or other plugs were used, state the character of same and depth placed, from _____ feet to _____ feet for each plug set.

Filled the hole with sand from 3242' to 3220' and ran 5 sacks of cement. Mudded the hole to 245', set a 10' rock bridge and ran 30 sacks of cement. Mudded the hole to 30', set a 10' rock bridge and ran 20 sacks of cement on top. Plugging completed.

RECEIVED
STATE CORPORATION COMMISSION
02-20-56

Name of Plugging Contractor West Supply Co., Inc. (If additional description is necessary, use BACK of this sheet)
Address Chase, Kansas

STATE OF Kansas, COUNTY OF Sedwick, ss.
_____, (employee of owner) or (owner or operator) of the above-described well, being first duly sworn on oath, says: That I have knowledge of the facts, statements, and matters herein contained and the log of the above-described well as filed and that the same are true and correct. So help me Gdd.

(Signature) E. E. Bues
Chase, Kansas (Address)

SUBSCRIBED AND SWORN TO before me this 20th day of February, 19 56
Seward S. Greider
Notary Public.

My commission expires Jan. 31, 1957
My commission expires _____

PLUGGING
FILE SEC 13 T 16 R 12W
BOOK PAGE 28 LINE 6


WELL LOG BUREAU KANSAS GEOLOGICAL SOCIETY
412 Union National Bk. Bldg., Wichita, Kansas

Company R. E. DAY ET AL
Farm Dolechek No. 6

SEC. 13 T. 16 R. 12 W
CS/2 SW SW

Total Depth. 3241'
Comm. 2-25-46 Comp. 4-20-46
Shot or Treated.
Contractor.
Issued. 5-11-46

County. Barton
KANSAS

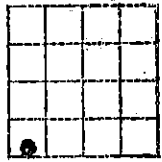

CASING:

12 1/2"	355'	7"	3148'
10"	776'	5 1/2"	3241' Cem.
8"	2197'		

Elevation. _____

Production. Pot. 521 B.

Figures Indicate Bottom of Formations.

soil	10	red rock	2000	lime	3241
post rock	15	lime	2015	Total Depth.	
clay yellow	20	red rock	2020		
shale blue	115	shale blue	2035		
shale blk	135	lime	2055	Water Record:	
shale blue	205	shale blue	2060	2 BW 230-40'	
red rock	230	red rock	2085	2 BW 1815-45'	
water sand	240	lime	2130	2 BW 2165-70'	
red rock	260	shale	2145	1 BW 2475-80'	
shale blue	280	red rock	2150	HFV 3145-50'	
red rock	345	lime	2175		
shale blue	355	shale blk	2185	Show oil 3000-05'	
shale gy	375	shale gy	2190	Show oil 3225-28'	
water sand	460	lime sft	2197	H. F. oil 3230-41'	
shale	470	lime	2220		
shale blue	490	shale	2240		
iron & sand	494	shale blue	2260		
shale	500	lime	2265		
shale blue	525	shale blue	2298		
red rock	776	lime	2303		
anhydrite	803	shale blue	2325		
red rock	1000	shale &			
shale blue	1055	shells	2375		
red rock	1110	shale blue	2445		
shale blue	1220	lime	2455		
salt	1465	lime brkn	2480		
shale blue	1475	shale blue	2505		
lime	1490	lime	2520		
shale blue	1505	lime brkn	2535		
lime	1510	lime	2570		
red rock	1515	shale blue	2575		
lime	1525	lime	2585		
shale blue	1550	shale blue	2600		
lime	1555	shale &			
shale blue	1565	shells	2640		
lime	1580	lime	2665		
lime & shale	1605	shale blue	2675		
lime	1635	lime	2805		
shale lgt	1660	shale blue	2815		
lime	1670	lime	2905		
lime hrd	1695	shale blue	2910		
shale blue	1705	lime	2970		
red rock	1720	shale blue	2980		
lime	1745	lime	2995		
shale blue	1750	red rock	3000		
lime wh	1800	lime	3005		
lime sft	1845	shale	3040		
lime hrd	1850	shale sdy	3050		
red rock	1875	lime	3060		
shale blue	1890	shale brwn	3070		
lime	1920	lime	3135		
shale blue	1925	shale	3140		
lime	1935	lime	3170		
shale gy	1945	shale	3175		
red rock	1955	lime	3180		
lime	1970	lime hrd	3200		
red rock	1975	lime	3220		
lime	1985	shale	3225		

PLUGGING
FILE SEC 13 T 16 R 12 W
BOOK PAGE 28 LINE 6