


Give All Information Completely  
Make Required Affidavit  
Mail or Deliver Report to:  
Conservation Division  
State Corporation Commission  
800 Bittling Building  
Wichita, Kansas

WELL PLUGGING RECORD

OR 15-009-19350-0000  
FORMATION PLUGGING RECORD

Strike out upper line  
when reporting plug-  
ging off formations.

NORTH 1/2 W

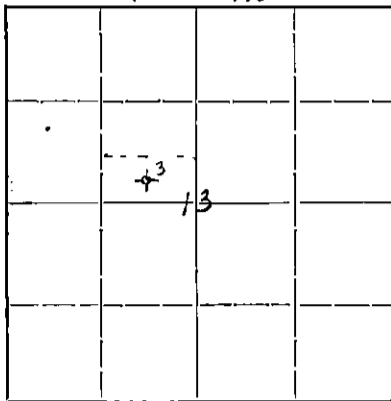

Locate well correctly on above  
Section Plat

Barton County. Sec. 13 Twp. 16 Rge. 12 (NW West)  
Location as "NE 1/4 NW 1/4 SW 1/4" or footage from lines. C.S./2 SE NW  
Lease Owner. Phillips Petroleum Company  
Lease Name. Nick Weber Well No. 3  
Office Address. Box 779, Great Bend, Kansas  
Character of Well (completed as Oil, Gas or Dry Hole) Dry hole  
Date, well completed. 2-1-41 19.  
Application for plugging filed. 2-4-41 19.  
Application for plugging approved. 2-4-41 19.  
Plugging Commenced. 2-4-41 19.  
Plugging Completed. 2-4-41 19.  
Reason for abandonment of well or producing formation No saturation  
If a producing well is abandoned, date of last production. 19.  
Was permission obtained from the Conservation Division or its agents before plugging was com-  
menced? Yes

Name of Conservation Agent who supervised plugging of this well. C.T. Alexander  
Producing formation. Arbuckle (Dry) Depth to top. 3378 Bottom. 3398 Total Depth of Well. 3398 Feet  
Show depth and thickness of all water, oil and gas formations.


OIL, GAS OR WATER RECORDS

CASING RECORD

Formation	Content	From	To	Size	Put In	Pulled Out
Lime				8 5/8	504 ft	None
				This pipe	cemented to surface	
See formation record attached. This was rotary hole and no apparent oil, water or gas encountered.						

Describe in detail the manner in which the well was plugged, indicating where the mud fluid was placed and the method or methods used in introducing it into the hole. If cement or other plugs were used, state the character of same and depth placed, from feet to feet for each plug set.

This well spudded January 18, 1941 and was drilled to total depth of 3398 feet on February 1, 1941. No saturation was found in Arbuckle and well plugged in following manner. On February 4th filled hole with heavy mud from bottom to 494 feet. Spotted 25 sacks cement with Halliburton from 494 to 414 feet. Filled with heavy mud from 414 ft. to 48 ft. Spotted 15 sacks cement from 48 feet to surface. Well plugged and abandoned.

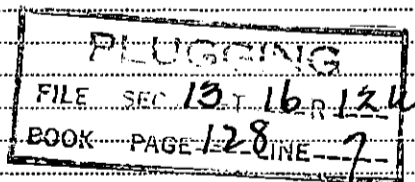

02-10-41

(If additional description is necessary, use BACK of this sheet)

Correspondence regarding this well should be addressed to. Phillips Petroleum Company  
Address. Box 779, Great Bend, Kansas

STATE OF Kansas, COUNTY OF Barton, ss.  
I, F.W. Shelton (employee of owner) of the above-described well,  
being first duly sworn on oath, says: That I have knowledge of the facts, statements, and matters herein contained and the log of the above-described well as filed and that the same are true and correct. So help me God.

(Signature)

Box 779, Great Bend, Kansas  
(Address)

SUBSCRIBED AND SWORN to before me this 8th day of February, 1941.

My commission expires April 26, 1944

Notary Public.

## Formation Record

Lease N. Weber

Well No. 3

FROM	TO	Formation	REMARKS
0	32	Surface and sand	
32	225	Sand and lime and shale	
225	510	Shale and lime	
510	750	Shale and red beds	
750	780	Anhydrite and pyrite	
780	808	Shale and shells	
808	930	Shale and shells	
930	1195	Shale, shells and salt	
1195	1682	Shale and lime	
1682	1750	Lime and shale breaks	
1750	1833	Lime	
1833	2109	Lime and shale	
2109	2379	Shale	
2379	2509	Shale and lime	
2509	2557	Sticky shale and lime	
2557	2722	Shale	
2722	2806	Shale and lime	
2806	2859	Lime	
2859	2882	Lime	
2882	2949	Lime and shale	
2949	3361	Lime	
3361	3398	Lime and sand	Top Arbuckle 3378. No sat.
3398	TOTAL DEPTH		

This well plugged and abandoned February 4, 1941

