


STATE OF KANSAS
STATE CORPORATION COMMISSION

WELL PLUGGING RECORD

Give All Information Completely
Make Required Affidavit
Mail or Deliver Report to
Conservation Division
State Corporation Comm.
245 North Water
Wichita, KS 67202

Rice County, Sec. 27 Twp. 21 Rge. 8W E/W
Location as "NE/CNW 1/4 SW 1/4" or footage from lines
C W/2 SW 1/4

Lease Owner Energy Exploration, Inc. (Kelso Casing Pulling)
Lease Name Fitzpatrick #1 Well No. _____
Office Address Wichita, Kansas 67202
Character of Well (Completed as Oil, Gas or Dry Hole) _____

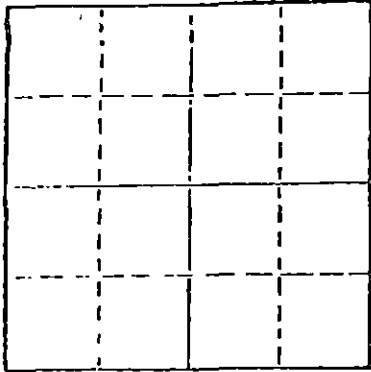

Locate well correctly on above
Section Plot

Date Well completed _____ 19____
Application for plugging filed _____ 19____
Application for plugging approved _____ 19____
Plugging commenced 9/26/79 _____ 19____
Plugging completed 10/1/79 _____ 19____
Reason for abandonment of well or producing formation
depleted.

If a producing well is abandoned, date of last production
_____ 19____

Was permission obtained from the Conservation Division or
its agents before plugging was commenced? yes

Name of Conservation Agent who supervised plugging of this well Toman
Producing formation _____ Depth to top _____ Bottom _____ Total Depth of Well 3310
Show depth and thickness of all water, oil and gas formations.

OIL, GAS OR WATER RECORDS

CASING RECORD

FORMATION	CONTENT	FROM	TO	SIZE	PUT IN	PULLED OUT
				8-5/8	277	none
				4 1/2"	3309	2342

Describe in detail the manner in which the well was plugged, indicating where the mud fluid
was placed and the method or methods used in introducing it into the hold. If cement or other
plugs were used, state the character of same and depth placed, from _____ feet to
_____ feet for each plug set.

Sanded to 3100' and ran 3 sacks cement. Shot pipe at 2800', 2717', ~~2717'~~
2633', 2466', 2346', pulled 57 joints. Allied pumped 3 sacks hulls,
20 sacks gel, plug and 85 sacks 50-50 pos, 2% gel.

PLUGGING COMPLETE.

RECEIVED
STATE CORPORATION COMMISSION

OCT 12 1979 10-12-79

(If additional description is necessary, use BACK of this sheet)

Name of Plugging Contractor KELSO CASING PULLING
CHASE, KANSAS

STATE OF KANSAS COUNTY OF RICE, ss.
R. DARRELL KELSO (employee of owner) or (owner or operator)
of the above-described well, being first duly sworn on oath, says: That I have knowledge of
the facts, statements, and matters herein contained and the log of the above-described well
as filed and that the same are true and correct. So help me God.

(Signature) R. Darrell Kelso
CHASE, KANSAS

(Address)

SUBSCRIBED AND SWORN TO before me this 5th day of October, 19 79

Margaret Melcher
Notary Public.

My commission expires



EMPHASIS OIL OPERATIONS

P. O. Box 506
Russell, Kansas 67665

DRILLERS LOG

OPERATOR: Energy Exploration, Inc.
505 Insurance Bldg.
Wichita, KS 67202

CONTRACTOR: Emphasis Oil Operations
Box 506
Russell, KS 67665

LEASE: Fitzpatrick

WELL: #1

LOCATION: C W/2 SW/4
Section 27-21S-8W
Rice County, Kansas

Total Depth: 3310'

Elevation: 1637' K.B.

Commenced: 9-23-78

Completed: 10-2-78

Casing: 8-5/8" @ 277'
4-1/2" @ 3309'

Status: Oil Well

DEPTHS & FORMATIONS

(All measurements from K.B.)

Sand & Shale	285	Lime & Shale	1420
Shale	729	Shale & Lime	2640
Anhydrite	770	Lime & Shale (R.T.D.)	3310
Shale & Lime	1138		

STATE OF KANSAS)
COUNTY OF RUSSELL) ss

I, Joe K. Branum, of Emphasis Oil Operations state that the above and foregoing is a true and correct log of the above captioned well.

RECEIVED
STATE CORPORATION COMMISSION
OCT 11 1979
CONSERVATION DIVISION
Wichita, Kansas

Joe K. Branum

Joe K. Branum

Subscribed and sworn to before me this 2nd day of October, 1978.

My Commission Expires: October 2, 1979.

Patricia L. Clark

Notary Public

