


WELL PLUGGING RECORD

Give All Information Completely  
Make Required Affidavit  
Mail or Deliver Report to:  
Conservation Division  
State Corporation Commission  
800 Biting Building  
Wichita, Kansas

NORTH

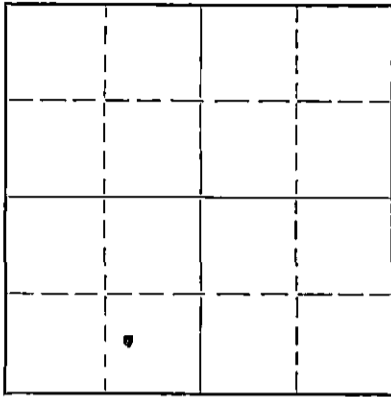

Locate well correctly on above  
Section Plot

Rice County. Sec. 24 Twp. 21 Rge. 8 (E) 8 (W)  
Location as "NE/CNW $\frac{1}{4}$ SW $\frac{1}{4}$ " or footage from lines SW/4 SW/4 SW/4  
Lease Owner Carpenter and Lay et al  
Lease Name Kemper Well No. 1  
Office Address Wichita, Kansas  
Character of Well (completed as Oil, Gas or Dry Hole) Dry Hole  
Date well completed September 25, 1951  
Application for plugging filed September 25, 1951  
Application for plugging approved September 25, 1951  
Plugging commenced September 25, 1951  
Plugging completed September 25, 1951  
Reason for abandonment of well or producing formation Dry Hole

If a producing well is abandoned, date of last production 19  
Was permission obtained from the Conservation Division or its agents before plugging was commenced? Yes

Name of Conservation Agent who supervised plugging of this well Mr. Durkee, McPherson, Kansas  
Producing formation \_\_\_\_\_ Depth to top \_\_\_\_\_ Bottom \_\_\_\_\_ Total Depth of Well 3415 Feet  
Show depth and thickness of all water, oil and gas formations.

OIL, GAS OR WATER RECORDS

CASING RECORD

Formation	Content	From	To	Size	Put In	Pulled Out
				<u>8-5/8"</u>	<u>150'</u>	<u>None</u>
				<u>Circulated top to bottom.</u>		

Describe in detail the manner in which the well was plugged, indicating where the mud fluid was placed and the method or methods used in introducing it into the hole. If cement or other plugs were used, state the character of same and depth placed, from 3415 feet to 0 feet for each plug set.

Gunned pits. Filled hole with heavy mud through drill pipe. When one-half way out of hole, gunned pits again and filled hole with heavy mud to 150. Set a permanent plug at 150. Mixed 15 sacks of cement and poured it through drill pipe on top of plug. Filled hole with heavy mud to 15' below cellar; Set a plug and mixed 5 sacks of cement and poured on top of plug to top of hole.

SEP 27 1951  
9-27-51

(If additional description is necessary, use BACK of this sheet)

Correspondence regarding this well should be addressed to Stearns Petroleum, Inc.  
Address Russell, Kansas

STATE OF KANSAS, COUNTY OF RUSSELL, ss.  
O. G. STEARNS (employee of owner) or (owner or operator) of the above-described well, being first duly sworn on oath, says: That I have knowledge of the facts, statements, and matters herein contained and the log of the above-described well as filed and that the same are true and correct. So help me God.

(Signature) [Signature]  
Russell, Kansas  
(Address)

SUBSCRIBED AND SWORN TO before me this 26th day of September, 1951

[Signature]  
Notary Public.

My commission expires June 20, 1953

FILE SEC 24 N. R. 10  
PAGE 11, 12, 15

**KEMPER #1**

Operator: Carpenter & Lay  
 Contractor: Stearns Petroleum, Inc.  
 Commencement Date: September 13, 1951  
 Completion Date: September 25, 1951

Location: SW/4 SW/4 SW/4,  
 24-21-8, Rice County, Kansas.

Elevation: 1626' D. F.

Casing Record:  
 8-5/8" 150'  
 Cemented w/275 sacks

Tops:  
 Heebner 2759  
 Lansing 2945  
 Mississippi 3373  
 Kinderhook 3400

WELL LOG


Sand	0	95
Red Bed	95	150
Red Bed and Shale	150	290
Shale and Red Rock	290	685
Salt and Shale	685	900
Shale and Shells	900	1220
Shale and Lime	1220	2200
Shale	2200	2420
Lime and Shale	2420	2945
Lime	2945	3235
Lime and Chert	3235	3270
Lime	3270	3360
Conglomerate	3360	3377
Chat	3377	3400
Kinderhook	3400	3415
Total Depth	3415	

State of Kansas )  
 County of Russell ) ss

I hereby certify that the above information is true and correct to the best of my knowledge.

*[Signature]*

Subscribed and Sworn to before me this 26th day of September, 1951.

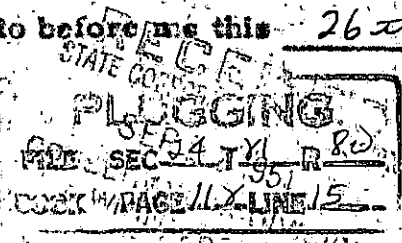

*Harold J. Urbinek*  
 Notary Public

My Commission Expires: June 20, 1953