


Give All Information Completely
Make Required Affidavit
Mail or Deliver Report to:
Conservation Division
State Corporation Commission
211 No. Broadway
Wichita, Kansas

WELL PLUGGING RECORD

Rice County, Sec. 18 Twp. 21 Rge. (E) 8 (W)

Location as "NE/CNW/SW" or footage from lines. NE NE NE
Lease Owner Ben C. W. Hyde, Jr.
Lease Name McClintock Well No. 1
Office Address 4722 Broadway, Kansas City 12, Missouri
Character of Well (completed as Oil, Gas or Dry Hole) oil
Date well completed 19
Application for plugging filed May 13 19 64
Application for plugging approved 19
Plugging commenced May 15 19 64
Plugging completed May 18 19 64
Reason for abandonment of well or producing formation depleted

NORTH

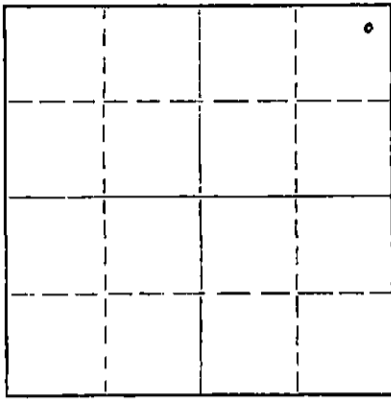

Locate well correctly on above Section Plat

If a producing well is abandoned, date of last production 19
Was permission obtained from the Conservation Division or its agents before plugging was commenced? yes

Name of Conservation Agent who supervised plugging of this well Gilbert Toman
Producing formation Depth to top Bottom Total Depth of Well 3510 Feet
Show depth and thickness of all water, oil and gas formations.

OIL, GAS OR WATER RECORDS

CASING RECORD

FORMATION	CONTENT	FROM	TO	SIZE	PUT IN	PULLED OUT
		0	223'	8 5/8"	223'	none
		0	3510'	4 1/2"	3510'	3024.27

Describe in detail the manner in which the well was plugged, indicating where the mud fluid was placed and the method or methods used in introducing it into the hole. If cement or other plugs were used, state the character of same and depth placed, from feet to feet for each plug set.

Push plug to 3275', set 10' rock bridge and dump 3 sacks of cement.

Set plug at 220', set 10' sand and rock bridge and dump 20 sacks of cement. Fill hole with mud to 40', set 10' rock bridge and cap with 10 sacks of cement. Hole plugged 12 noon.

RECEIVED
STATE CORPORATION COMMISSION

MAY 26 1964

CONSERVATION DIVISION
Wichita, Kansas

(If additional description is necessary, use BACK of this sheet)
Name of Plugging Contractor Pipe Pullers, Inc.
Address Box 486, Ellinwood, Kansas

STATE OF Kansas, COUNTY OF Barton, ss.
Dean Wells (employee of owner) or (owner or operator) of the above-described well, being first duly sworn on oath, says: That I have knowledge of the facts, statements, and matters herein contained and the log of the above-described well as filed and that the same are true and correct. So help me God.

(Signature) Dean Wells
Ellinwood, Kansas
(Address)

SUBSCRIBED AND SWORN to before me this 25 day of May, 19 64

My commission expires July 7, 1964 Notary Public.

W E L L L O G

Ben C. W. Hyde, Jr. - owner McCLINTOCK #1
NE NE NE Section 18-21-8
Rice County, Kansas

Figures indicate bottom of formation:

Elevation: 1654 KB

PIPE RECORD:

8 5/8" set at 223' with
200 sacks of pozmix HA5.
4 1/2" set at 3510 with
125 sacks of cement.

ROTARY COMMENCED: 5-19-62
ROTARY COMPLETED: 5-30-62

GEOLOGICAL TOPS:

Heebner 2715
Brown Lime 2852
Lansing 2890
Miesner 3280
Viola 3390
Simpson 3391
Arbuckle 3466

0	to	10	cellar
		70	sand
		220	shale & shells
		770	shale
		900	shale & shells
		1050	salt
		1190	shale & shells
		1380	lime & shale
		1505	lime
		1800	shale & lime
		1925	shale & shells
		2160	shale
		2305	shale & shells
		2450	lime & shale
		2585	shale & lime
		2810	lime & shale
		2905	shale
		3215	lime & shale
		3294	lime, shale, & chert
		3380	lime
		3481	lime & shale
		3510	lime
		3510	Rotary Total Depth

RECEIVED
STATE CORPORATION COMMISSION

MAY 14 1964

CONSERVATION DIVISION
Wichita, Kansas

STATE OF KANSAS)
) ss
COUNTY OF BARTON)

I, Richard Hogg, Drilling Superintendent of the above-described well, being first duly sworn on oath, declare: That I have knowledge of the facts, statements and matter herein contained pertaining to the log of the above-described well, as filed, and that the same are true and correct.

Richard Hogg
Richard Hogg

Subscribed and sworn to before me on this 5th day of June, 1962.

George A. Meyer
George A. Meyer, Notary Public

My Commission expires February 10, 1963.